

U.S. PUBLIC LAND SURVEY MONUMENT RECORD


Note: This form is intended and designed to fulfill all requirements of Wisconsin Administrative Code, Chapter A-E 5.02, U.S. Public Land Survey Monument Record (3) (a) (b) (c) (d) (e) (f) (g) (h) (i). An additional sheet may be added if necessary to conform with said requirements.

(a) Corner location: Township 35 North

Range 8 East

Town/City/Village Harrison


County Lincoln

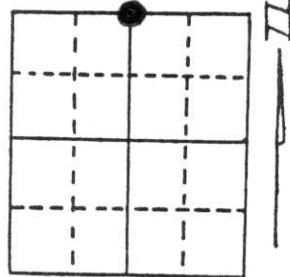

Section 33

(b) (f) (g) (h) Description of monument found at this corner and if it was accepted, state all evidence (material, testimonial, occupational, plats, records, other monuments) used as a basis for accepting. If not accepted or if nothing was found, state evidence used as basis for establishing location. If reestablished through lost corner proportionate methods, indicate all monuments, distances and directions used to establish. Original Gov't. Survey: Apr. 1865 by James L. Nowlin, set wood post for corner with bearings, white pine 10 S50° W 15 links and hemlock 12 S 46° E 17 links. I found no evidence of the corner or witnesses at or near the corner. Keg Road has a large fill at the corner location. This made it not possible to excavate for evidence of the corner. I used the witness of Jacob VanRyen, a life long resident, who lives just to the northwest of the corner location. He indicated the old fence line to the west being extended easterly to the centre-line of Keg Road is where he feels the corner was many year ago. I set a Berntsen monument at this location for the corner and witnessed as shown below.

(c) (d) (e) Plan view of corner with ties to at least 4 witness monuments. If in disagreement with previously established corner, show the distances between the two corners and also indicate the ties to the disputed corner.

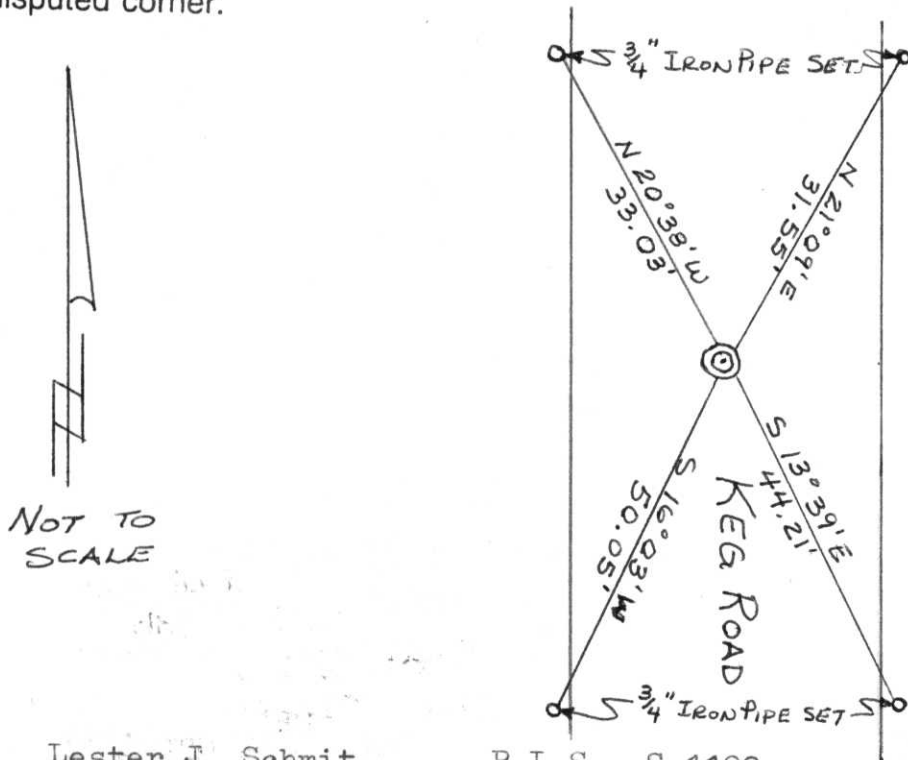

NOT TO SCALE

(i) I, Lester J. Schmit R.L.S. S-1192

(type or print name) certify that the corner location on this record was determined by me or under my direction and control and that this U.S. Public Land Survey Monument Record is correct and complete to the best of my knowledge and belief.

Lester J. Schmit
Signature

18 Nov 94
Date



Index No. 11-C