

Sec. 5-35-6

RS-7150-11 (9/1/56)

H.C. Miller Company

~~NECR~~

CERTIFIED LAND CORNER RESTORATION

State of Wisconsin }
County of Oneida } ss.

I, John H. Fisher, do hereby certify that on the 26th day of February, 1981, I found evidence of the southeast corner of Section 32 Township 36N, Range 6E, Fourth Principal Meridian, as described hereon; and that from this evidence I established a new monument and accessories as described hereon to perpetuate the original location of this corner:

Description of original monument and accessories and subsequent restorations:

The original Gov't. survey was performed by Herman C. Fellow, Deputy Surveyor in May 1859.

- Set wood post
- 12" Yellow Pine, N30°E, 63 links
- 12" Yellow Pine, S58°E, 60 links
- 11" White Pine, S15°W, 43 links
- 15" Yellow Pine, N70°W, 121 links


Description of corner evidence found:

- Found 2" iron pipe with 1" iron pipe inside
- 12" Oak, S16°W, 16.7 feet
- 14" Double White Birch S33°E, 39.4 feet
- 12" Twin Oak N66°E, 70.1 feet

Description of monument and accessories I established to perpetuate the location of this corner:

Found corner and bearing trees in good shape and in no need of perpetuation.

REGISTER OF DEEDS OFFICE
ONEIDA COUNTY, WIS.

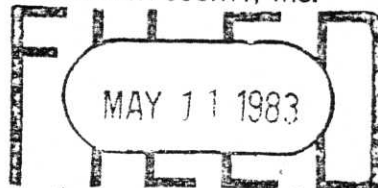


At 4:13 O'Clock P.M.
DORIS VERAGE KUEHN
REGISTER OF DEEDS

COMPARED WITH ALL RECORD
DATA & ACCEPTED AS CORRECT.

Robert H. Wink

ONEIDA CO. SURVEYOR 27 APR. 1983

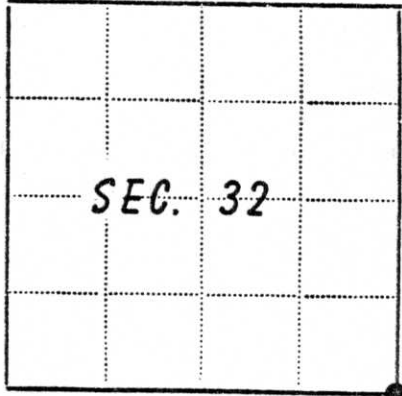

- - Corner monument restored
- -

Resident witnesses None

Dated at Minocqua Wisconsin, this 13 day of March 1981

Signature *John H. Fisher* Title Registered Land Surveyor
(County Surveyor, Registered Land Surveyor, or other duly authorized official)

Surveyors Registration No. S-836

Office of _____ County of _____

I hereby certify that the within instrument was filed in this office for record on the _____ day of _____ 19____, and was filed in Book No. _____ Page No. _____ of County Records.

Signature _____ Title _____

Township _____, Range _____, Section _____, Index No. _____, Page No. _____

Index # 20 A-4