


# U.S. PUBLIC LAND SURVEY MONUMENT RECORD

**Note:** This form is intended and designed to fulfill all requirements of Wisconsin Administrative Code, Chapter A-E 7.08 U.S. Public Land Survey Monument Record (3) (a) (b) (c) (d) (e) (f) (g) (h) (i). An additional sheet may be added if necessary to conform with said requirements.

(a) Corner location: Township 36 North  
 Range 7 East/West  
 Town/City/Village Woodboro  
 County Oneida

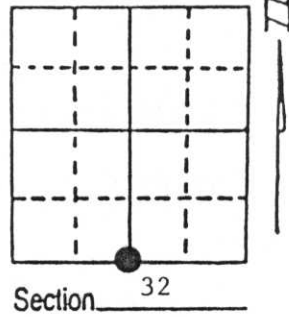

*N 1/4 cr 5-35-7*

(b) (f) (g) (h) Description of monument found at this corner and if it was accepted, state all evidence (material, testimonial, occupational, plats, records, other monuments) used as a basis for accepting. If not accepted or if nothing was found, state evidence used as basis for establishing location. If reestablished through lost corner proportionate methods, indicate all monuments, distances and directions used to establish. Indicate type of monument found or set and sign post.

August 31, 1860 - Alfred Millard established this corner and set a wood post with two BTs:  
 16" Y. Pine, S81°E, 23 Links                      10" W. Pine, S79°W, 19 Links


October 22, 1949 - Wincentzen used iron pipe in road when he was working south side of section 32. A Witness Corner is 33.00' north and two new BTs:  
 6" Aspen, N57°W, 72 Links                      6" Cherry, N10°W, 30 Links

July 27, 1989 - Milo E. Stefan found a 3" x 24" iron pipe in road in collar of small stone and Witness Corner and location poster post North 33.0'. No evidence of BTs remain.  
 I accept this iron pipe as the perpetuated corner position and restore same by placement of a county monument, making new BTs and placing a plastic sign post.

(c) (d) (e) Plan view of corner with ties to at least 4 witness monuments. If in disagreement with previously established corner, show the distances between the two corners and also indicate the ties to the disputed corner.

- 1) 2" x 30" Aluminum County Monument with iron pipe buried along side.
- 2) 4" Red Oak, N86°E, 119.67'
- 3) 10" Red Oak, S69°E, 80.49'
- 4) 7" Red Pine, S17°W, 30.50'
- 5) 7" Red Pine, S50°W, 44.85'
- 6) Witness Corner, 1" iron pipe; Location Corner Post and Plastic Sign Post, North, 33'

Distances to nail in side of BTs.  
 BTs scribed "BT" in stump blaze.

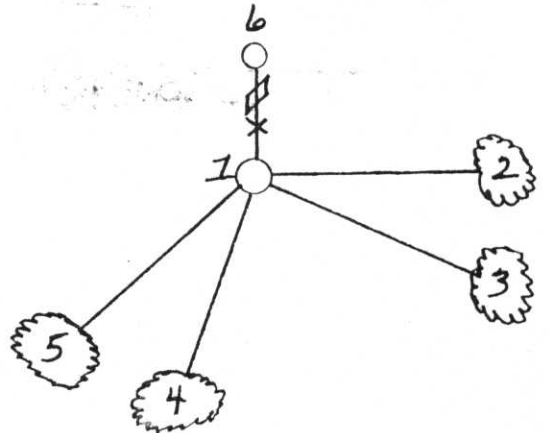

(i) I, Milo E. Stefan  
 (type or print name) certify that the corner location on this record was determined by me or under my direction and control and that this U.S. Public Land Survey Monument Record is correct and complete to the best of my knowledge and belief.

Milo E. Stefan                      8/5/89  
 Signature                                      Date



Index No. 24  
A-7

CERTIFIED LAND CORNER RESTORATION

State of Wisconsin }  
County of \_\_\_\_\_ } ss.

I \_\_\_\_\_, do hereby certify that on the \_\_\_\_\_ day of \_\_\_\_\_, 19\_\_\_\_\_, I found evidence of the \_\_\_\_\_ corner of \_\_\_\_\_ Township \_\_\_\_\_, Range \_\_\_\_\_, Fourth Principal Meridian, as described hereon; and that from this evidence I established a new monument and accessories as described hereon to perpetuate the original location of this corner:

Description of original monument and accessories and subsequent restorations:

Description of corner evidence found:

Description of monument and accessories I established to perpetuate the location of this corner:

RECEIVED AT LINCOLN COUNTY  
COURTHOUSE THIS 18th DAY  
OF August 19 89.  
Pat Priebe  
TAX DESCRIPTION OFFICE


- Corner monument restored
- 

Resident witnesses \_\_\_\_\_

Dated at \_\_\_\_\_ Wisconsin, this \_\_\_\_\_ day of \_\_\_\_\_ 19\_\_\_\_\_.

Signature \_\_\_\_\_ Title \_\_\_\_\_  
(County Surveyor, Registered Land Surveyor, or other duly authorized official)

Surveyors Registration No. \_\_\_\_\_

Office of \_\_\_\_\_ County of \_\_\_\_\_

I hereby certify that the within instrument was filed in this office for record on the \_\_\_\_\_ day of \_\_\_\_\_ 19\_\_\_\_\_, and was filed in Book No. \_\_\_\_\_ Page No. \_\_\_\_\_ of County Records.

Signature \_\_\_\_\_ Title \_\_\_\_\_

Township \_\_\_\_\_, Range \_\_\_\_\_, Section \_\_\_\_\_, Index No. \_\_\_\_\_, Page No. \_\_\_\_\_

