

CERTIFIED LAND CORNER RESTORATION

Index No. 25

State of Wisconsin


County of Oneida } ss.

I William E. Badow, do hereby certify that on the 23rd day of January, 1981, I found evidence of the Southeast corner of Section 31 Township 36, North, Range 8 East, Fourth Principal Meridian, as described hereon; and that from this evidence I established a new monument and accessories as described hereon to perpetuate the original location of this corner.

Resident witnesses:

Sec. 6-35-8
NE cr.

31 - 36 - 8

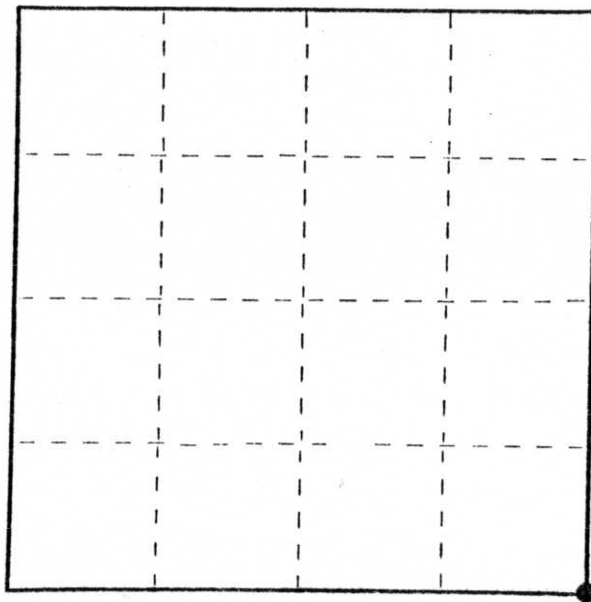

○ = Corner monument restored.

History of original corner establishment:

Corner set by Alex Anderson in 1860. West between Sections 5 & 32. 80.00 set post.

BT's White Birch 8" N 70°E 25 Links
Yellow Pine 10" N 40°W 10 Links
Yellow Pine 10" S 46°W 11 Links
White Pine 10" S 24°E 28 Links

Description of corner evidence found:

No restorations on record.

Found a 6"x6" red granite monument from which a Spruce bears N 58°W 25.5' (14") and a 16" Norway Pine bears N 68°E 18.5'.

Description of monument and accessories I established to perpetuate the original location of this corner.

Red granite monument remains in place. Made 1 new BT.

White Pine 12" S 20°W 33.7'

Distances are to center of trees.



Dated at Rhinelander, Wis., this 9th day of February, 1981

Signature William E. Badow Title Registered Land Surveyor Registration No. S-1182
(County Surveyor, Registered Land Surveyor, or other duly authorized official)

Office of Register of Deeds, County of Oneida, I hereby certify that the within instrument was filed in this office for record on the 11 day of June, 1986 at 2:03 o'clock P M.

Doris Verage Kuehn
(Register of Deeds)

By Cynthia A. Pits Deputy