

CERTIFIED LAND CORNER RESTORATION


Index No. A, 15-16

State of Wisconsin }
County of Lincoln } ss.

I William E. Bandow, do hereby certify that on the 30th day of November, 1984, I found evidence of the East MC on North line corner of Section 3 Township 35, North, Range 8 East, Fourth, Principal Meridian, as described hereon; and that from this evidence I established a new monument and accessories as described hereon to perpetuate the original location of this corner.

Resident witnesses:

Carl Rollman

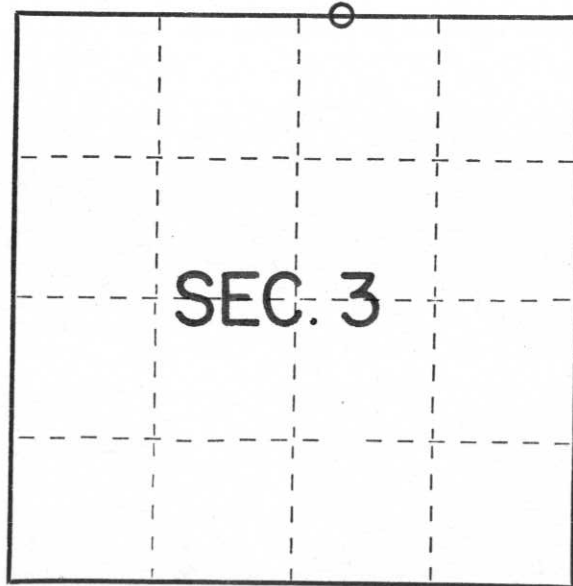

○ = Corner monument restored.

History of original corner establishment:

Corner set by Alfred Millard in 1863. West between 3 & 34 34.50 to Wisconsin River & set meander post. BT Maple 12" S70W 14 lks.

Description of corner evidence found:

D.H. Vaughan at corner in 1898. He found original BT. We found a fence line leading to an old maple stub. Local resident Carl Rollman was told by his father this was a BT. They erected a fence from the BT East. Vaughan's distance from MC east to the North $\frac{1}{4}$ corner of Section 2 was 4880.7'. Our distance is 4884.05'

Description of monument and accessories I established to perpetuate the original location of this corner.

Set aluminum monument & made the following BT's: Existing Maple stub S70W 9.2' 6" spike in W. Pine 20" S9W 5.84', 6" spike in W. Birch 9" N58E 10.43', 6" spike in W. Pine 21" S79E 33.00'.

Dated at Rhineland, Wis., this 5th day of December, 1984

Signature William E. Bandow Title Registered Land Surveyor Registration No. S-1182
(County Surveyor, Registered Land Surveyor, or other duly authorized official)

Office of Register of Deeds, County of _____, I hereby certify that the within instrument was filed in this office for record on the _____ day of _____, 19____ at _____ o'clock _____ M.

(Register of Deeds)

By _____ Deputy