

CERTIFIED LAND CORNER RESTORATION


Index No. A-19

State of Wisconsin }
County of Lincoln } ss.

I William E. Bandow, do hereby certify that on the 30th day of November, 1984, I found evidence of the North 1/4 corner of Section 2 Township 35, North, Range 8 East, Fourth, Principal Meridian, as described hereon; and that from this evidence I established a new monument and accessories as described hereon to perpetuate the original location of this corner.

Resident witnesses:

.....
.....
.....

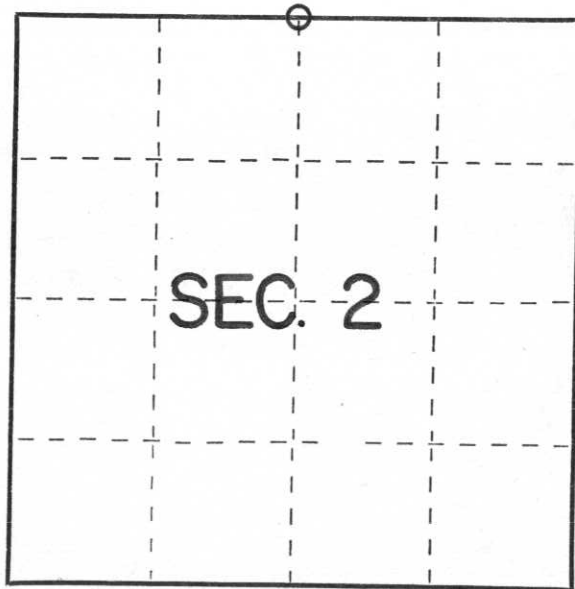

○ = Corner monument restored.

History of original corner establishment:

Corner set by Alfred Millard in 1863. West between 2 & 35 40.00 set 1/4 post. BT's Spruce 10" N22W 231ks, W. Pine 8" S34E 181ks. D.H. Vaughan was at corner in 1899. Found B.F. Dorr's corner in center of E-W road & center of road to North.

Description of corner evidence found:

I found a 1/2" iron pipe down 3" at intersection of E-W & N roads.

Description of monument and accessories I established to perpetuate the original location of this corner.

Iron pipe remains in place. Set 6" nails in the side of the following trees: N. Pine 8" S40E 19.37', W. Pine 6" S65W 30.70', J. Pine 12" N40W 74.30', J. Pine 8" N18W 79.85'.

Dated at Rhineland, Wis., this 5th day of December, 1984

Signature: William E. Bandow Title Registered Land Surveyor Registration No. S-1182
(County Surveyor, Registered Land Surveyor, or other duly authorized official)

Office of Register of Deeds, County of _____, I hereby certify that the within instrument was filed in this office for record on the _____ day of _____, 19____ at _____ o'clock _____ M.

.....
(Register of Deeds)

By.....Deputy