

U.S. PUBLIC LAND SURVEY MONUMENT RECORD


Note: This form is intended and designed to fulfill all requirements of Wisconsin Administrative Code, Chapter A-E 7.08 U.S. Public Land Survey Monument Record (3) (a) (b) (c) (d) (e) (f) (g) (h) (i). An additional sheet may be added if necessary conform with said requirements.

(a) Corner location: Township 36 North
 Range 8 East/West

Town/City/Village Crescent

County Oneida

NECR
1-35-8

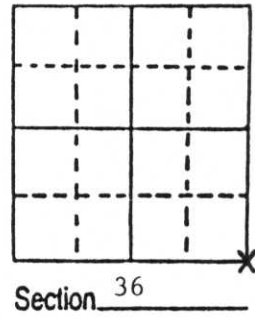

(b) (f) (g) (h) Description of monument found at this corner and if it was accepted, state all evidence (material, testimonial, occupational, plats, records, other monuments) used as a basis for accepting. If not accepted or if nothing was found, state evidence used as basis for establishing location. If reestablished through lost corner proportionate methods, indicate all monuments, distances and directions used to establish. Indicate type of monument found or set and sign post.

7/1859 - Hiram Fellows at 82.69 Chains established Town Corner 233 links north of temporary corner and set a wood post with BTs as follows:
 9" Sugar, N65°E, 20 links 12" Birch, S40°W, 13 links
 11" Pine, S71°E, 13 links 7" Birch, N28°W, 9 links

7/12/1894 - B.F. Dorr found pine BT and set iron pipe with new BT:
 20" Elm, N48 3/4°E, 52 1/4 links


7/19/1935 - Maine found Dorr's BT, now a stump, and set 2" x 60" iron pipe with brass cap and new BTs:
 8" White Pine, N14°W, 118 links 7" Cedar, S38°E, 64 links

1/14/1989 - Milo E. Stefan found Maine monument with both BTs okay - made two new BTs and set sign post.

(c) (d) (e) Plan view of corner with ties to at least 4 witness monuments. If in disagreement with previously established corner, show the distances between the two corners and also indicate the ties to the disputed corner.

1. 2" iron pipe with brass cap
2. 10" Cedar, S38°E, 42.38'
3. 20" White Pine, S6°W, 66.65'
4. 12" Basswood, N46°W, 81.35'
5. 14" White Pine, N14°W, 78.15'
6. Plastic sign post.

Distances to nail in side of BT.

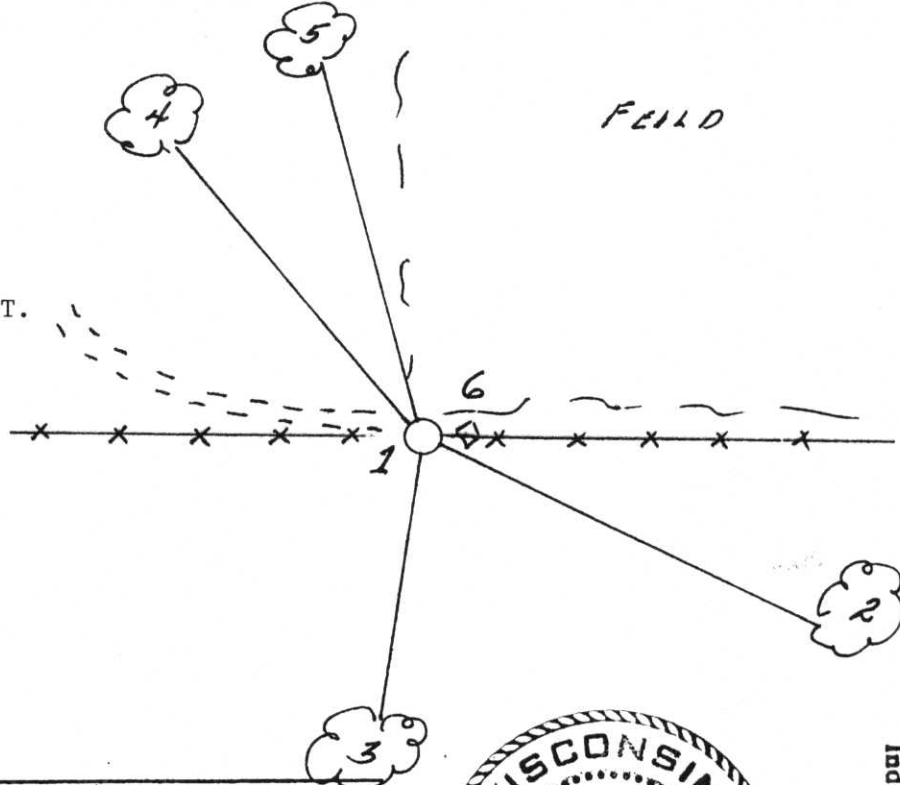

(i) I, Milo E. Stefan
 (type or print name) certify that the corner location on this record was determined by me or under my direction and control and that this U.S. Public Land Survey Monument Record is correct and complete to the best of my knowledge and belief.

Milo E. Stefan 2/16/89
 Signature Date

