

CERTIFIED LAND CORNER RESTORATION

Index No. E-8,9

State of Wisconsin }  
County of..... } ss.

History of original corner establishment:

I....., do hereby certify that on the..... day of....., 19....., I found evidence of the..... corner of..... Township..... 31....., North, Range..... 6....., Fourth, Principal Meridian, as described hereon; and that from this evidence I established a new monument and accessories as described hereon to perpetuate the original location of this corner.

Resident witnesses:



.....  
.....  
.....

Description of corner evidence found:

ORIGINAL CORNER OBLITERATED DUE TO CONSTRUCTION OF ALEXANDER DAM AND THE FLOODING OF LAND BY THE WATER OF THE RESERVOIR

Description of monument and accessories I established to perpetuate the ~~original~~ location of this corner.

SET LINCOLN COUNTY BERNTSEN MONUMENT

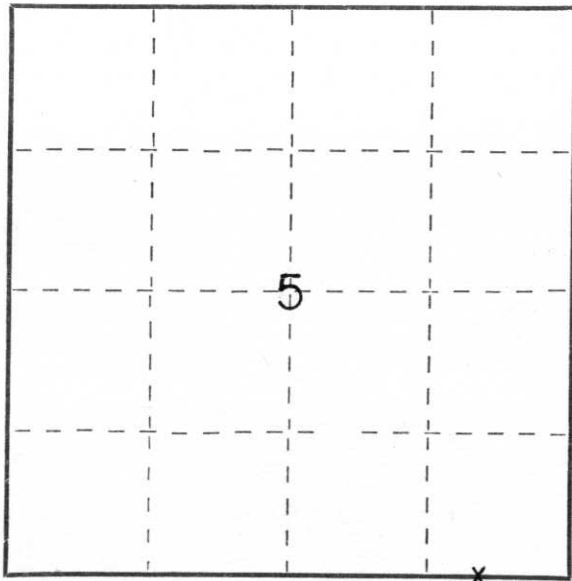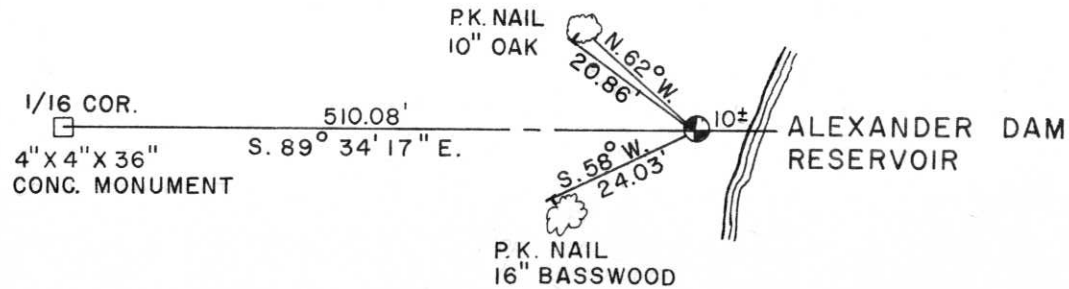

○ = Corner monument restored.

Dated at GREEN BAY, Wis., this 13<sup>th</sup> day of JULY, 19 81.

Signature Elton G. Petersen Title R. Land Surveyor Registration No. S-1304  
(County Surveyor, Registered Land Surveyor, or other duly authorized official)

Office of Register of Deeds, County of....., I hereby certify that the within instrument was filed in this office for record on the..... day of....., 19..... at..... o'clock..... M.

(Register of Deeds)

By..... Deputy