

CERTIFIED LAND CORNER RESTORATION

Index No. E-21

State of Wisconsin }
County of Lincoln } ss.

History of original corner establishment:

I Sheridan D. Schwark, do hereby certify that on the 21st day of June, 19 77, I found evidence of the Northeast section corner of Section 11 Township 31, North, Range 6 East, Fourth, Principal Meridian, as described hereon; and that from this evidence I established a new monument and accessories as described hereon to perpetuate the original location of this corner.

Date: April 29, 1852
Surveyors: Albert & Frederick Ellis
Monument: Wood post
Witnesses: 12" Hemlock S53°E, 28L
7" Hemlock S28¼W, 11L

Resident witnesses:

.....
.....
.....


Description of corner evidence found:

Checked with County Highway Department - Road has been excavated at expected location of section corner, with no monuments found. No bearing trees found. Established section corner location from previous recorded survey maps in area.

Description of monument and accessories I established to perpetuate the original location of this corner.

Set Lincoln County Berntson monument in intersection of Pier Street and Taylor Street, with following witness monuments:

- 3/4" x 30" round iron rod, + 1' South of telephone box #1764, bearing N60°E, 93.47'
- 3/4" x 30" round iron rod, + 1' West of 3-trunk Birch, bearing S78°E, 75.72'
- 3/4" x 30" round iron rod, + 1' East of hydrant #350, bearing S52°W, 57.05'
- 3/4" x 30" round iron rod, + 1' East of power pole #3106-2T61, bearing N60°W, 56.46'

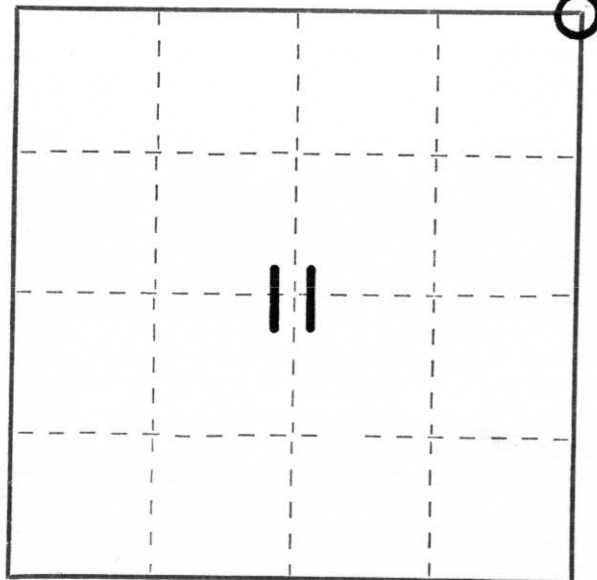

○ = Corner monument restored.

Dated at Merrill, Wis., this 8th day of July, 19 77.

Signature Sheridan D. Schwark Title Registered Land Surveyor Registration No. S-1205
(County Surveyor, Registered Land Surveyor, or other duly authorized official)

Office of Register of Deeds, County of....., I hereby certify that the within instrument was filed in this office for record on the..... day of....., 19..... at..... o'clock..... M..

.....
(Register of Deeds)

By..... Deputy