

# LINCOLN COUNTY U.S. PUBLIC LAND TIE SHEET RECORD

SECTION 29  
TOWNSHIP 33N  
RANGE 4 E

293348  
NO.

LANDMARK

CORNING  
CITY, VILLAGE, TOWN


CORNER INDENTITY: BERNSTEN MONUMENT

LINCOLN COUNTY COORDINATE: N: 169913.217

E: 311123.101

DATE OF SURVEY: June 25, 2008  
SURVEY PARTY: Eron/Rutzen

FOUND   
SET   
RE-SET   
RE-TIED

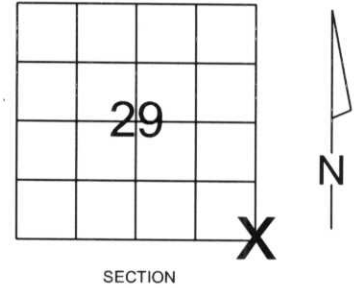

Description of monument found at this corner and if was accepted, state all evidence (material, testimonial, occupational, plats, records, other monuments) used as a basis for accepting. If not accepted or if nothing was found, state evidence used as basis for establishing location. If reestablished through lost corner proportionate methods, indicate all monuments, distances and directions used to establish.

## BASIS FOR MONUMENT LOCATION:

(DESCRIBE METHOD OF SURVEY AND CORNER AUTHENTICATION)

Set Lincoln County Bernsten Monument at Corner. Found 2.0 Iron Pipe with wood post 195 feet to the west. Did not hold the location of this corner due to discrepancies found in how it was established. Bernsten Monument was set using double proportion measurement method.



CERTIFIED CORRECT:

*Ronald K. Jacobson*

Ronald Jacobson RLS 2059-008

Registered Land Surveyor

DATE: June 27, 2008



**CWE, Inc.**


5707 SCHOFIELD AVE.  
WESTON, WISCONSIN  
54476

PHONE: (715) 359-9400  
FAX: (715) 355-4199

general@cwengineers.com  
www.cwengineers.com

## TIE SKETCH:

SHOW MINIMUM OF FOUR (4) HORIZONTAL TIE DISTANCES TO FIXED WITNESS MONUMENTS.  
DESCRIBE ALL MONUMENTS FOUND OR SET. ALL DISTANCES SHOWN IN US SURVEY FEET.

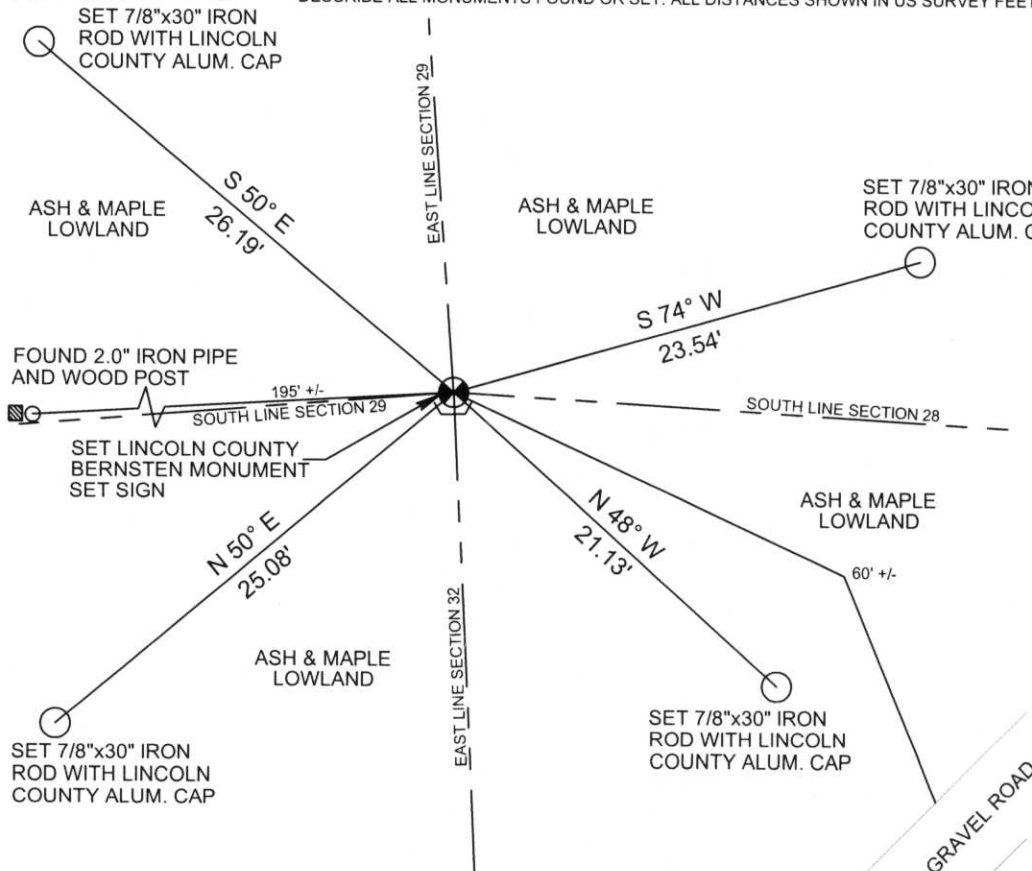

RECEIVED BY LINCOLN COUNTY  
SURVEYOR THIS 27<sup>TH</sup> DAY  
OF June 20 08  
*Tony Dalton*  
COUNTY SURVEYOR

COORDINATES ARE REFERENCED TO LINCOLN COUNTY COORDINATE SYSTEM AS DEVELOPED BY THE WI. DEPARTMENT OF TRANSPORTATION AND ARE BASED ON GPS OBSERVATIONS TO CONTROL POINTS AS SUPPLIED BY LINCOLN COUNTY.

NOT TO SCALE  
BEARINGS REFERENCED TO MAGNETIC NORTH

6-10



Picture 1 – Looking North From Corner



Picture 2 – Looking East From Corner





Picture 3 – Looking South From Corner



Picture 4 – Looking West From Corner





Picture 5 –Set Bernsten Monument

