


U.S. PUBLIC LAND SURVEY MONUMENT RECORD

NOTE: THIS FORM IS INTENDED AND DESIGNED TO FULFILL ALL REQUIREMENTS OF WISCONSIN ADMINISTRATIVE CODE, CHAPTER A-E 7.08, U.S. PUBLIC LAND SURVEY MONUMENT RECORD (3)(a)(b)(c)(d)(e)(f)(g)(h)(i). ADDITIONAL SHEETS MAY BE NECESSARY TO CONFORM TO SAID REQUIREMENTS.

(a) CORNER LOCATION:
SOUTHEAST CORNER, SECTION 22
TOWNSHIP 34 NORTH
RANGE 5 EAST
TOWN OF TOMAHAWK
LINCOLN COUNTY
WISCONSIN

(b) HISTORY OF ORIGINAL CORNER:
ORIGINAL SURVEYOR: Jackson L. Prentice
COMMENCING DATE: January 6, 1855
COMPLETION DATE: January 12, 1855
ORIGINAL BEARING TREES:
8" Spruce; S 60 W, 25 Links
8" Tamarack; N 37 E, 47 Links


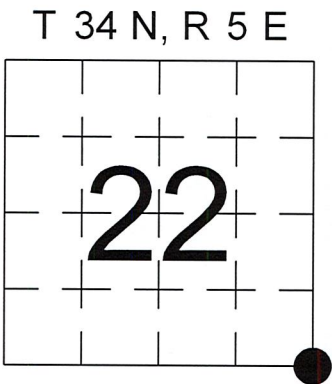


(f)(g)(h) DESCRIPTION OF MONUMENT FOUND AT THIS CORNER AND IF IT WAS ACCEPTED. STATE ALL EVIDENCE (MATERIAL, TESTIMONIAL, OCCUPATIONAL, PLATS, RECORDS, OTHER MONUMENTS) USED AS A BASIS FOR ESTABLISHING LOCATION. IF RE-ESTABLISHING THROUGH LOST CORNER PROPORTIONATE METHODS, INDICATE ALL MONUMENTS, DISTANCES, AND DIRECTIONS USED TO ESTABLISH. INDICATE TYPE OF MONUMENTS FOUND OR SET.


05/05/2026, I, Anthony R. Dallman, PLS-2405, unable to find any evidence of the original corner position, set a 60" Swamp Rod at double proportion position. I accepted this location and set witness monuments, as shown in the sketch below, to further perpetuate the corner location.

(c)(d)(e) PLAN VIEW OF THE CORNER WITH TIES TO AT LEAST FOUR WITNESSES. IF IN DISAGREEMENT WITH PREVIOUSLY ESTABLISHED CORNER, SHOW THE DISTANCES BETWEEN THE TWO CORNERS AND ALSO THE TIES TO THE DISPUTED CORNER.

- Tie bearings by hand-held compass.
- Tie distances by steel tape.
- Not to scale.

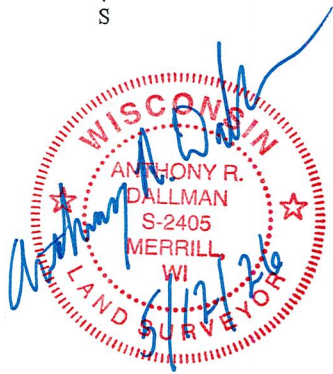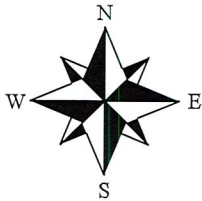

- - Set 30" Swamp Rod
- ⊥ - Vinyl Post

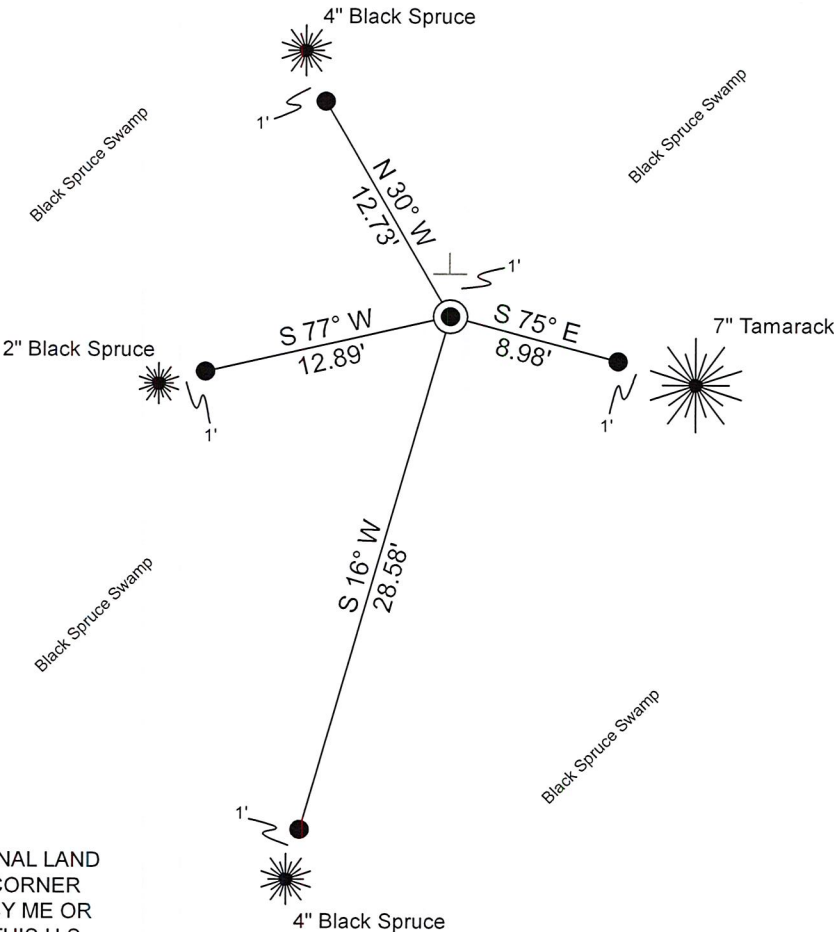

I, ANTHONY R. DALLMAN, WISCONSIN PROFESSIONAL LAND SURVEYOR, S-2405, HEREBY CERTIFY THAT THE CORNER LOCATION ON THIS RECORD WAS REFERENCED BY ME OR UNDER MY DIRECTION AND CONTROL AND THAT THIS U.S. PUBLIC LAND SURVEY MONUMENT RECORD IS COMPLETE TO THE BEST OF MY KNOWLEDGE AND BELIEF.

Anthony R. Dallman 5/12/26
ANTHONY R. DALLMAN, PLS S-2405

INDEX NO. Q-17

43405220000_Mon-N



43405220000_North



43405220000_West



43405220000_South



43405220000_East

