

CERTIFIED LAND CORNER RESTORATION


Index No. 9-7

State of Wisconsin }
County of Lincoln } ss.

I, Stuart L. Foltz, do hereby certify that on the 1st day of May, 1975, I found evidence of the South one-quarter corner of Section 32 Township 34 North, Range 7 East, Fourth, Principal Meridian, as described hereon; and that from this evidence I established a new monument and accessories as described hereon to perpetuate the original location of this corner.

Resident witnesses:

.....
.....
.....

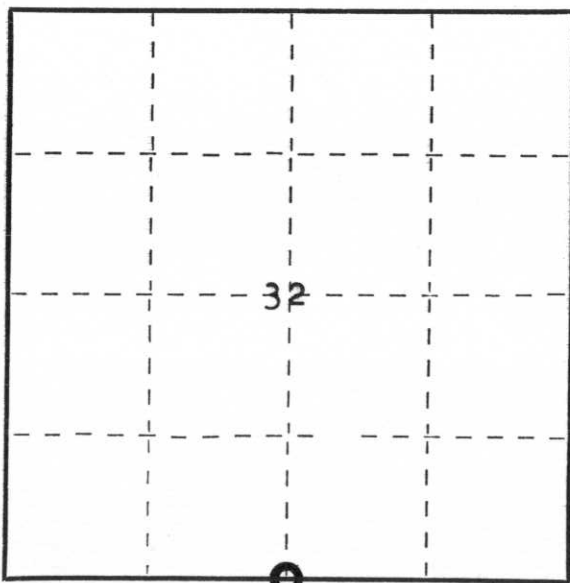

○ = Corner monument restored.

History of original corner establishment:

Surveyor: James M. Marsh
Date: May 10, 1851
Monument: Wood post
(Birch 12 S41°E 30 lks
(Birch 8 S52°W 34 lks
Witnesses:
(Birch 9 N20°W 10 lks
(Birch 9 N24°E 14 lks

Description of corner evidence found:

6"x 6" granite monument found (very loose) on North edge of private road at intersection of old fences coming from west and north.

Description of monument and accessories I established to perpetuate the original location of this corner.

Set Lincoln County cast aluminum Bernsten monument at granite monument location; removed granite monument from the area.

- P.K. nail with disc in 5" White Birch N60°W 18.2'
- P.K. nail with disc in 8" Oak N48°E, 18.5'
- P.K. nail with disc in 8" Maple S26°E, 103.7'
- P.K. nail with disc in 6" Maple S58°W, 103.0'

Dated at Minocqua, Wis., this 1st day of July, 1975.

Signature: *Stuart L. Foltz* Title Reg. Land Surveyor Registration No. S-1170
(County Surveyor, Registered Land Surveyor, or other duly authorized official)

Office of Register of Deeds, County of _____, I hereby certify that the within instrument was filed in this office for record on the _____ day of _____, 19____ at _____ o'clock _____ M.

.....
(Register of Deeds)
By _____ Deputy