## U.S. PUBLIC LAND SURVEY MONUMENT RECORD


Note: This form is intended and designed to fulfill all requirements of Wisconsin Administrative Code, Chapter A-E 5.02, U.S. Public Land Survey Monument Record (3) (a) (b) (c) (d) (e) (f) (g) (h) (i). An additional sheet may be added if necessary to conform with said requirements.

(a) Corner location: Township 35 North

Range 8 East

Town/City/Village \_\_Harrison

County \_\_\_\_Lincoln

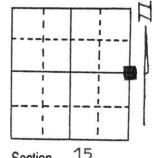


Section 15

(b) (f) (g) (h) Description of monument found at this corner and if it was accepted, state all evidence (material, testimonial, occupational, plats, records, other monuments) used as a basis for accepting. If not accepted or if nothing was found, state evidence used as basis for establishing location. If reestablished through lost corner proportionate methods, indicate all monuments, distances and directions used to establish. Original Gov't. Survey: 7 April 1865 by James L. Nowlin, set wood post for corner with bearings, birch 12 S 70° W 22 links & birch 8 N 55° E 5 links. During a survey in the 1930's, Francis Fox set a 6" x 6" red granite monument for the corner location as evidenced by original B.T.'s lying on the ground. He witnessed the corner with an ash 9" N 18° W 131.8 links and a cedar 11" N 80°E 247.9 links. I found the red granite monument which is the corner and witnessed it as shown below.

(c) (d) (e) Plan view of corner with ties to at least 4 witness monuments. If in disagreement with previously established corner, show the distances between the two corners and also indicate the ties to the disputed corner.

H

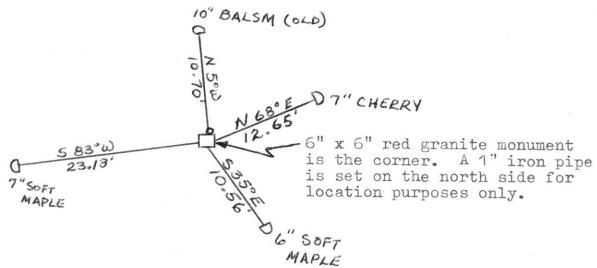

(i) I, Lester J. Schmit

(type or print name) certify that the corner location on this record was determined by me or under my direction and control and that this U.S. Public Land Survey Monument Record is correct and complete to the best of my knowledge and belief.

Sester J. Schmid

5 7/00-92 Date



Index No. XX