

# LINCOLN COUNTY U.S. PUBLIC LAND TIE SHEET RECORD

SECTION 22  
TOWNSHIP 33N  
RANGE 4 E

223347



**CORNING**  
CITY, VILLAGE, TOWN


NO.

CORNER IDENTIVITY: BERNSTEN MONUMENT

LINCOLN COUNTY COORDINATE: N: 174524.112  
E: 319028.843

DATE OF SURVEY: November 19, 2008  
SURVEY PARTY: Eron

FOUND   
SET   
RE-SET   
RE-TIED

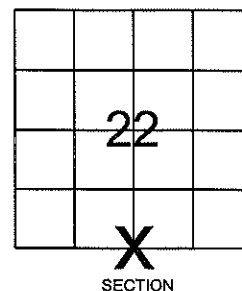


Description of monument found at this corner and if was accepted, state all evidence (material, testimonial, occupational, plats, records, other monuments) used as a basis for accepting. If not accepted or if nothing was found, state evidence used as basis for establishing location. If reestablished through lost corner proportionate methods, indicate all monuments, distances and directions used to establish.

## BASIS FOR MONUMENT LOCATION:

(DESCRIBE METHOD OF SURVEY AND CORNER AUTHENTICATION)

Set Lincoln County Bernsten Monument at Corner. No evidence of the corner remained. Bernsten Monument was set using single proportion measurement method.

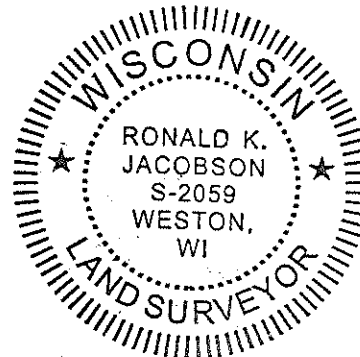

CERTIFIED CORRECT:

*Ronald K. Jacobson*

Ronald Jacobson RLS 2059-008

Registered Land Surveyor

DATE: November 24, 2008



**CWE, Inc.**


5707 SCHOFIELD AVE.  
WESTON, WISCONSIN  
54476

PHONE: (715) 359-9400  
FAX: (715) 355-4199

general@cwengineers.com  
www.cwengineers.com

## TIE SKETCH:

SHOW MINIMUM OF FOUR (4) HORIZONTAL TIE DISTANCES TO FIXED WITNESS MONUMENTS.  
DESCRIBE ALL MONUMENTS FOUND OR SET. ALL DISTANCES SHOWN IN US SURVEY FEET.

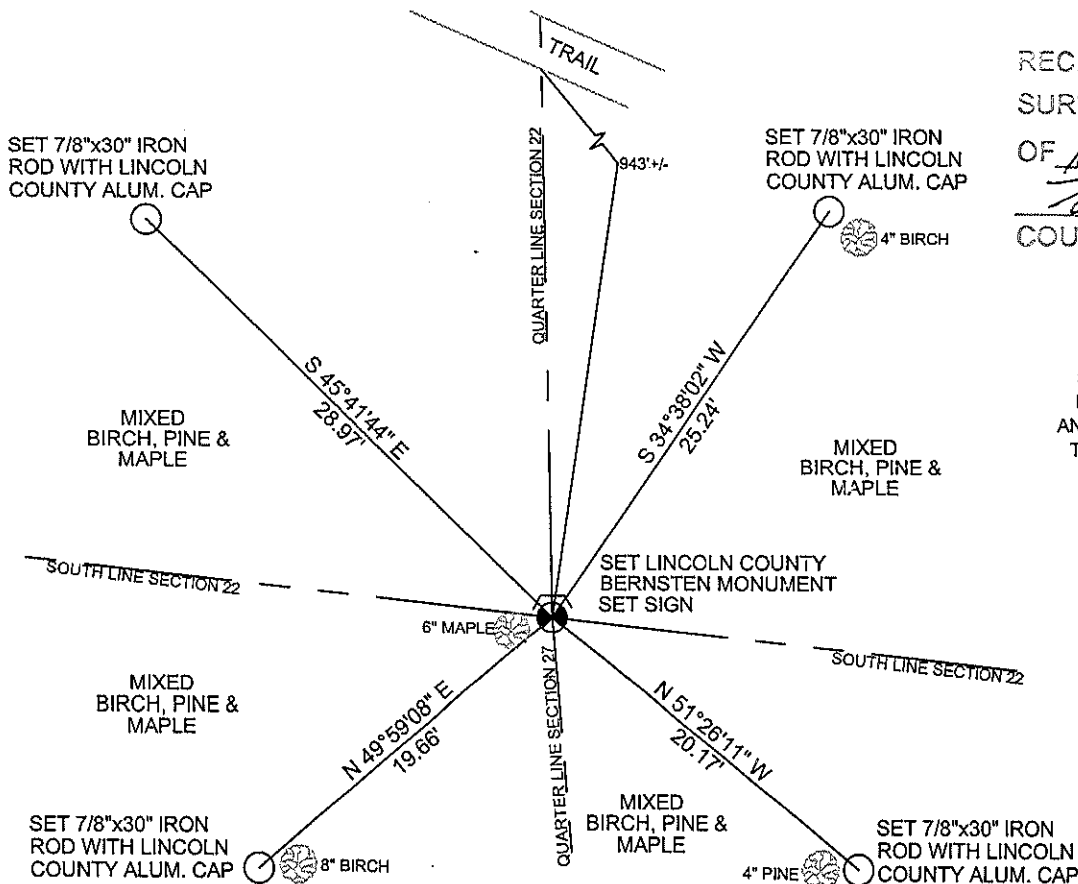

RECEIVED BY LINCOLN COUNTY  
SURVEYOR THIS 26<sup>TH</sup> DAY  
OF November 20 08  
*Terry Dull*  
COUNTY SURVEYOR

COORDINATES ARE REFERENCED  
TO LINCOLN COUNTY COORDINATE  
SYSTEM AS DEVELOPED BY THE WI.  
DEPARTMENT OF TRANSPORTATION  
AND ARE BASED ON GPS OBSERVATIONS  
TO CONTROL POINTS AS SUPPLIED BY  
LINCOLN COUNTY.

NOT TO SCALE  
BEARINGS REFERENCED  
TO LINCOLN COUNTY  
COORDINATE SYSTEM

Picture 1 – Looking North From Corner



Picture 2 – Looking East From Corner



Picture 3 – Looking South From Corner



Picture 4 – Looking West From Corner



Picture 5 –Set Bernsten Monument and Sign at Corner

