



SOLD TO
WIS. DEPT. OF TRANS.
DEC. 29, 1980, X-38000

 


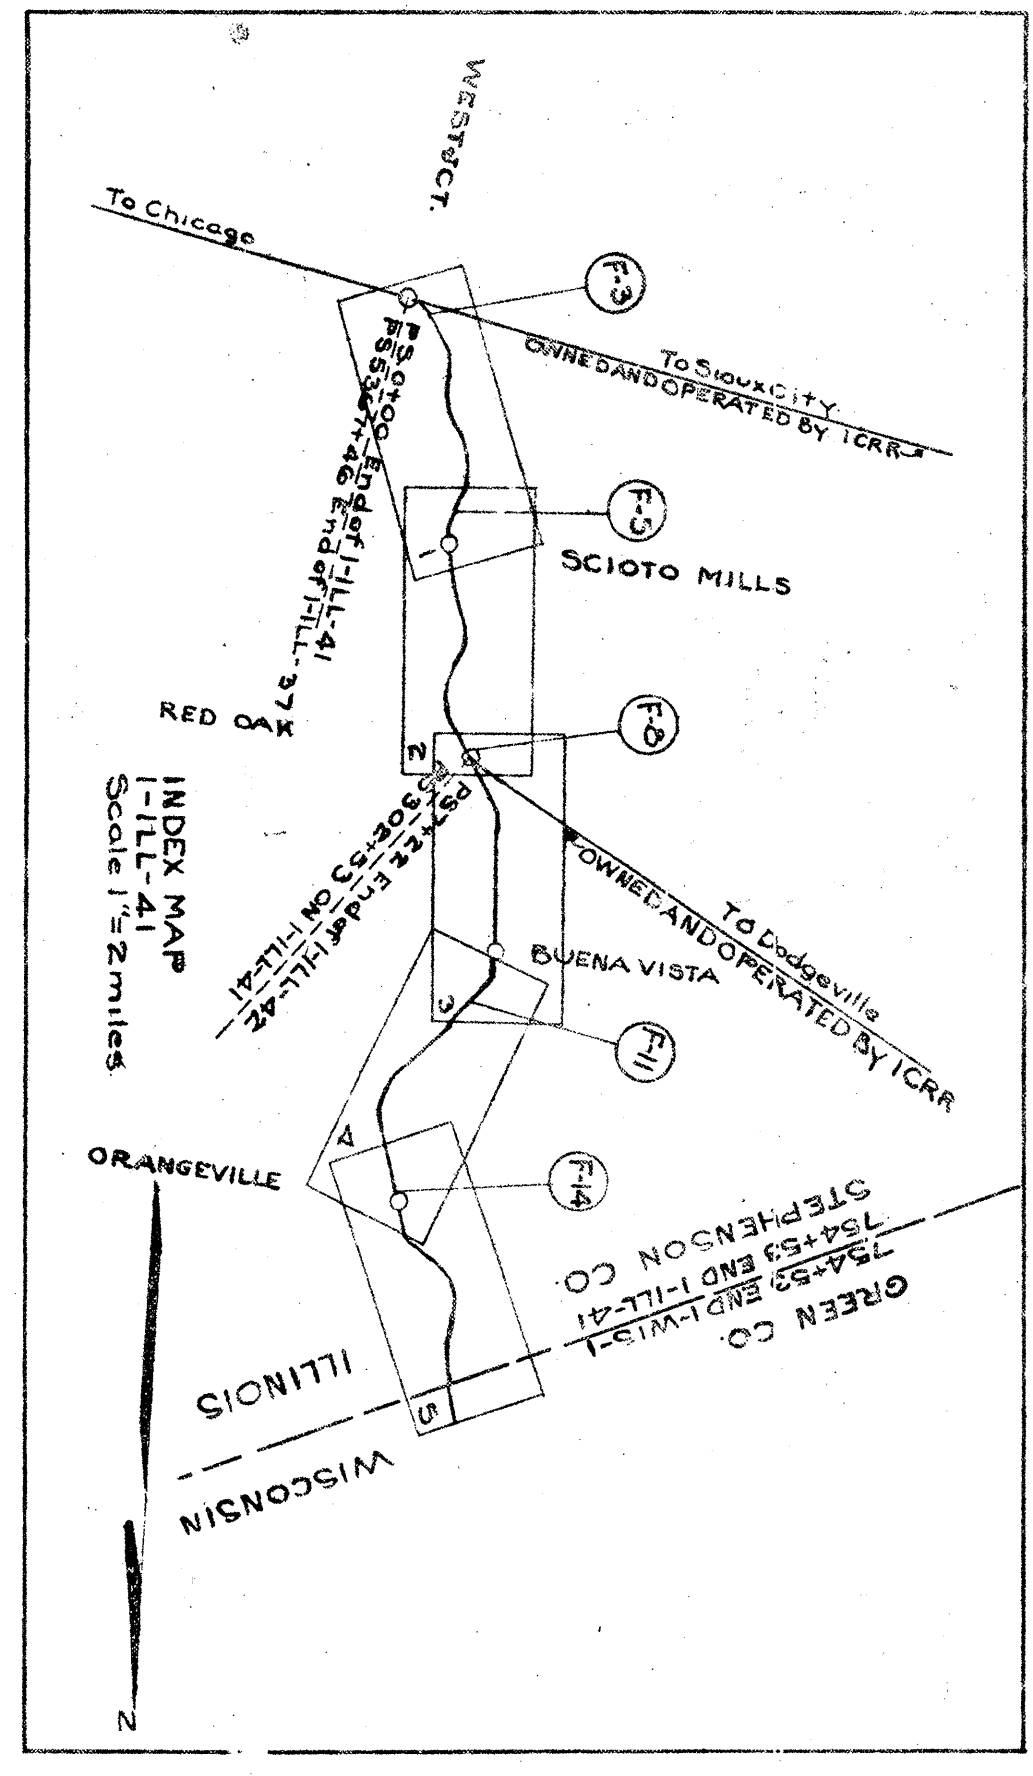

| No. | Station | Distance | Inter. | Date | Record | Cont. No. | Remarks |
|-----|----------------|----------|---------|--------|---------|-----------|---------|
| 1 | Hubbard & wife | 0.10 | 10-1-46 | 81-279 | 10-1-46 | 2 | |
| 2 | Hubbard & wife | 0.10 | 7-20-46 | 79-511 | 7-21-46 | 1 | |
| 3 | Hubbard & wife | 0.10 | 7-20-46 | 81-135 | 9-22-46 | 1 | |
| 4 | Hubbard & wife | 0.10 | 7-20-46 | 79-611 | 7-21-46 | 1 | |
| 5 | Hubbard & wife | 0.10 | 7-20-46 | 81-285 | 9-22-46 | 1 | |
| 6 | Hubbard & wife | 0.10 | 7-20-46 | 79-611 | 7-21-46 | 1 | |
| 7 | Hubbard & wife | 0.10 | 7-20-46 | 81-285 | 9-22-46 | 1 | |
| 24 | Hubbard & wife | 0.10 | 7-20-46 | 79-611 | 7-21-46 | 1 | |




RIGHT-OF-WAY AND TRACK MAP
ILLINOIS CENTRAL RAILROAD
WEST JCT., ILL. TO ILL.-WIS. STATE LINE


STATION 0+00 TO STATION 137+38
M. P. F. 2.42 TO M. P. F. 5
SCALE: 1" = 300 FT.

DATE: 10/1/81
OFFICE OF CIVIL ENGINEER
CHICAGO, ILL.

SOLD TO
 WIS. DEPT. OF TRANS.
 DEC. 29-1980. X-38000

| Sheet | Year | Description | Scale |
|-------|------|-----------------|-----------|
| 1 | 1917 | Original Survey | 1" = 400' |
| 2 | 1917 | Original Survey | 1" = 400' |
| Sheet | Date | By | Remarks |
|-------|---------|---------------------|---------|
| 1 | 9-18-17 | H. J. Fisher & wife | |
| 2 | 9-18-17 | Conroy, Highway | |
| 3 | 9-18-17 | H. J. Fisher & wife | |
| 4 | 9-18-17 | Conroy, Highway | |
 

SCIOTA MILLS, ILL.

Fence Notes:
 Ref. W. on East 137+36 to 137+15 S.W.W.
 137+36 to 137+00 S.W.W. 26' W.V.V.
 137+00 to 137+30 S.W.W. 26' W.V.V.


RIGHT-OF-WAY AND TRACK MAP
ILLINOIS CENTRAL RAILROAD
WEST JCT., ILL. TO ILL.-WIS. STATE LINE
 STATION 137+00 TO STATION 293+34
 M. P. F. 5 TO M. P. F. 8
 SCALE 1" = 500 FT.
 OFFICE OF CHIEF ENGINEER.
 CHICAGO, ILL.
 JUNE 30, 1918.
 Lead Rev. Dec. 31, 1917.

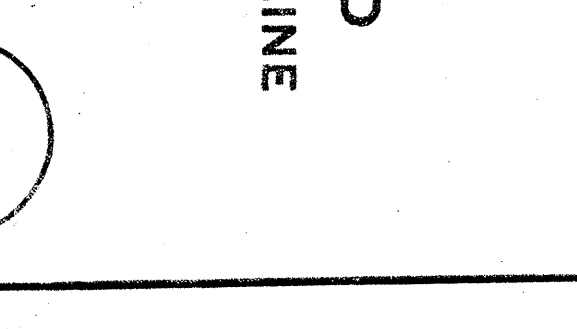

Sheet No. 1 of 2 of the Illinois Central Railroad Company, from survey station 0+00 to survey station 0+00

DRUMNER No. 25


SOLD TO
WIS. DEPT. OF TRANS.
DEC. 29-1980, X-38000

 


| No. | Owner | Acres | Record | Date | Int'l. | Cont. No. | Remarks |
|-----|----------------------|-------|--------|---------|--------|-----------|---------|
| 1 | J. J. Hendon & wife | 30 | 61-282 | 9-17-96 | W.D. | 61-282 | 49 |
| 2 | R. Siegfried & wife | 21 | 64-105 | 8-18-97 | W.D. | 64-105 | 49 |
| 3 | D. A. Johnson & wife | 23 | 61-289 | 9-23-96 | W.D. | 61-289 | 49 |
| 4 | D. A. Johnson & wife | 23 | 61-282 | 9-23-96 | W.D. | 61-282 | 49 |
| 5 | J. J. Hendon & wife | 23 | 61-282 | 9-17-96 | W.D. | 61-282 | 49 |
| 6 | J. J. Hendon & wife | 23 | 61-282 | 9-17-96 | W.D. | 61-282 | 49 |
| 7 | Gen. A. Davis & wife | 23 | 61-282 | 9-17-96 | W.D. | 61-282 | 49 |
| 8 | Gen. A. Davis & wife | 23 | 61-282 | 9-17-96 | W.D. | 61-282 | 49 |
Fence Notes:
R. of W. on West
230+24 to 300+30 P.V. etc.
310+00 to 324+70 G.B.W.
324+70 to 342+10 G.B.W.
342+10 to 370+10 G.B.W.
370+10 to 372+70 G.B.W.
372+70 to 379+70 G.B.W.
379+70 to 411+56 G.B.W.
411+56 to 415+00 G.B.W.
415+00 to 423+87 G.B.W.
423+87 to 433+87 G.B.W.
433+87 to 435+00 G.B.W.
435+00 to 436+00 G.B.W.
436+00 to 437+00 G.B.W.
437+00 to 438+00 G.B.W.
499+00 to 500+00 G.B.W.

RIGHT-OF-WAY AND TRACK MAP
ILLINOIS CENTRAL RAILROAD
WEST JCT., ILL. TO ILL.-WIS. STATE LINE
STATION 255+34 TO STATION 453+67
M. P. 11 TO M. P. 11
SCALE: 1 IN. = 300 FT.
OFFICE OF CHIEF ENGINEER
CHICAGO, ILL.

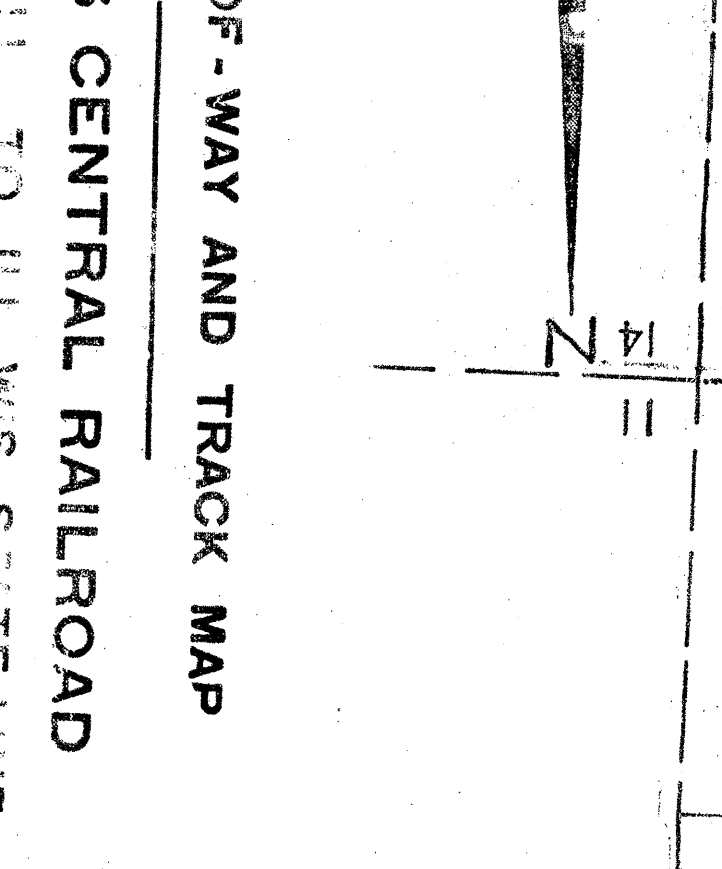

SOLD TO
 W.S. DEPT. OF TRANS
 DEC. 23-1901-X-38000

 

Fence Notes-
 R of W on West

| | | |
|------------------|-------|----------|
| 453+87 to 501+97 | 35' W | 26' W.W. |
| 502+88 to 519+47 | 30' W | 26' W.W. |
| 510+48 to 528+91 | 25' W | 26' W.W. |
| 529+92 to 548+35 | 20' W | 26' W.W. |
| 549+36 to 568+79 | 15' W | 26' W.W. |
| 569+80 to 588+23 | 10' W | 26' W.W. |
| 589+24 to 608+67 | 5' W | 26' W.W. |




| NO. | DATE | DESCRIPTION | BY |
|-----|----------|-------------|------|
| 1 | 7-25-06 | AS-BUILT | W.S. |

RIGHT - OF - WAY AND TRACK MAP
 ILLINOIS CENTRAL RAILROAD
 WEST JCT., ILL. TO ILL.-WIS. STATE LINE
 STATION 433+87 TO STATION 612+36
 M. P. F.-11 TO M. P. F.-14
 SCALE 1 IN. = 300 FT.
 OFFICE OF CHIEF ENGINEER
 CHICAGO, ILL.
 JUNE 30, 1915
 TO W. S. DEPT. OF TRANS
 DEC. 23, 1901-X-38000

| No. | ENGINEER | DATE | REVISION | CHAS. NO. | REMARKS |
|-----|-----------------|----------|----------|-----------|----------|
| 1 | J. W. H. & W.F. | 9-23-06 | 61-230 | 5-22-06 | AS-BUILT |

| No. | Description | Station | Length | Material | Remarks |
|-----|----------------------|------------------|--------|----------|---------|
| 1 | Track & bridge | 612+00 to 724+55 | 112+55 | Standard | |
| 2 | D.A. Shook & wife | 612+00 to 613+23 | 1+23 | Standard | |
| 3 | C. Johnson & wife | 613+23 to 613+60 | 37 | Standard | |
| 4 | H. Ober & wife | 613+60 to 617+82 | 44+22 | Standard | |
| 5 | M. Ober & wife | 617+82 to 618+18 | 36 | Standard | |
| 6 | H. Ober & wife | 618+18 to 622+58 | 44+40 | Standard | |
| 7 | J. Harding et al | 622+58 to 623+00 | 42 | Standard | |

 


RIGHT-OF-WAY AND TRACK MAP
ILLINOIS CENTRAL RAILROAD
WEST JCT., ILL. TO LEWIS & CLAY STATION
STATION 612+00 TO STATION 724+55
M. P. 1.4
SCALE: 1" = 200' FT.
OFFICE OF CHIEF ENGINEER
CHICAGO, ILL.
JAN. 10, 1911

CHICAGO, ILL.
JAN. 10, 1911


SOLD TO
WIS. DEPT. OF TRANS.
DEC. 29-1980, X-38000

| LS. | DATE | BY | REVISION |
|-----|----------|--------------|----------|
| 1 | 11-20-86 | W. R. F. 117 | 1 |

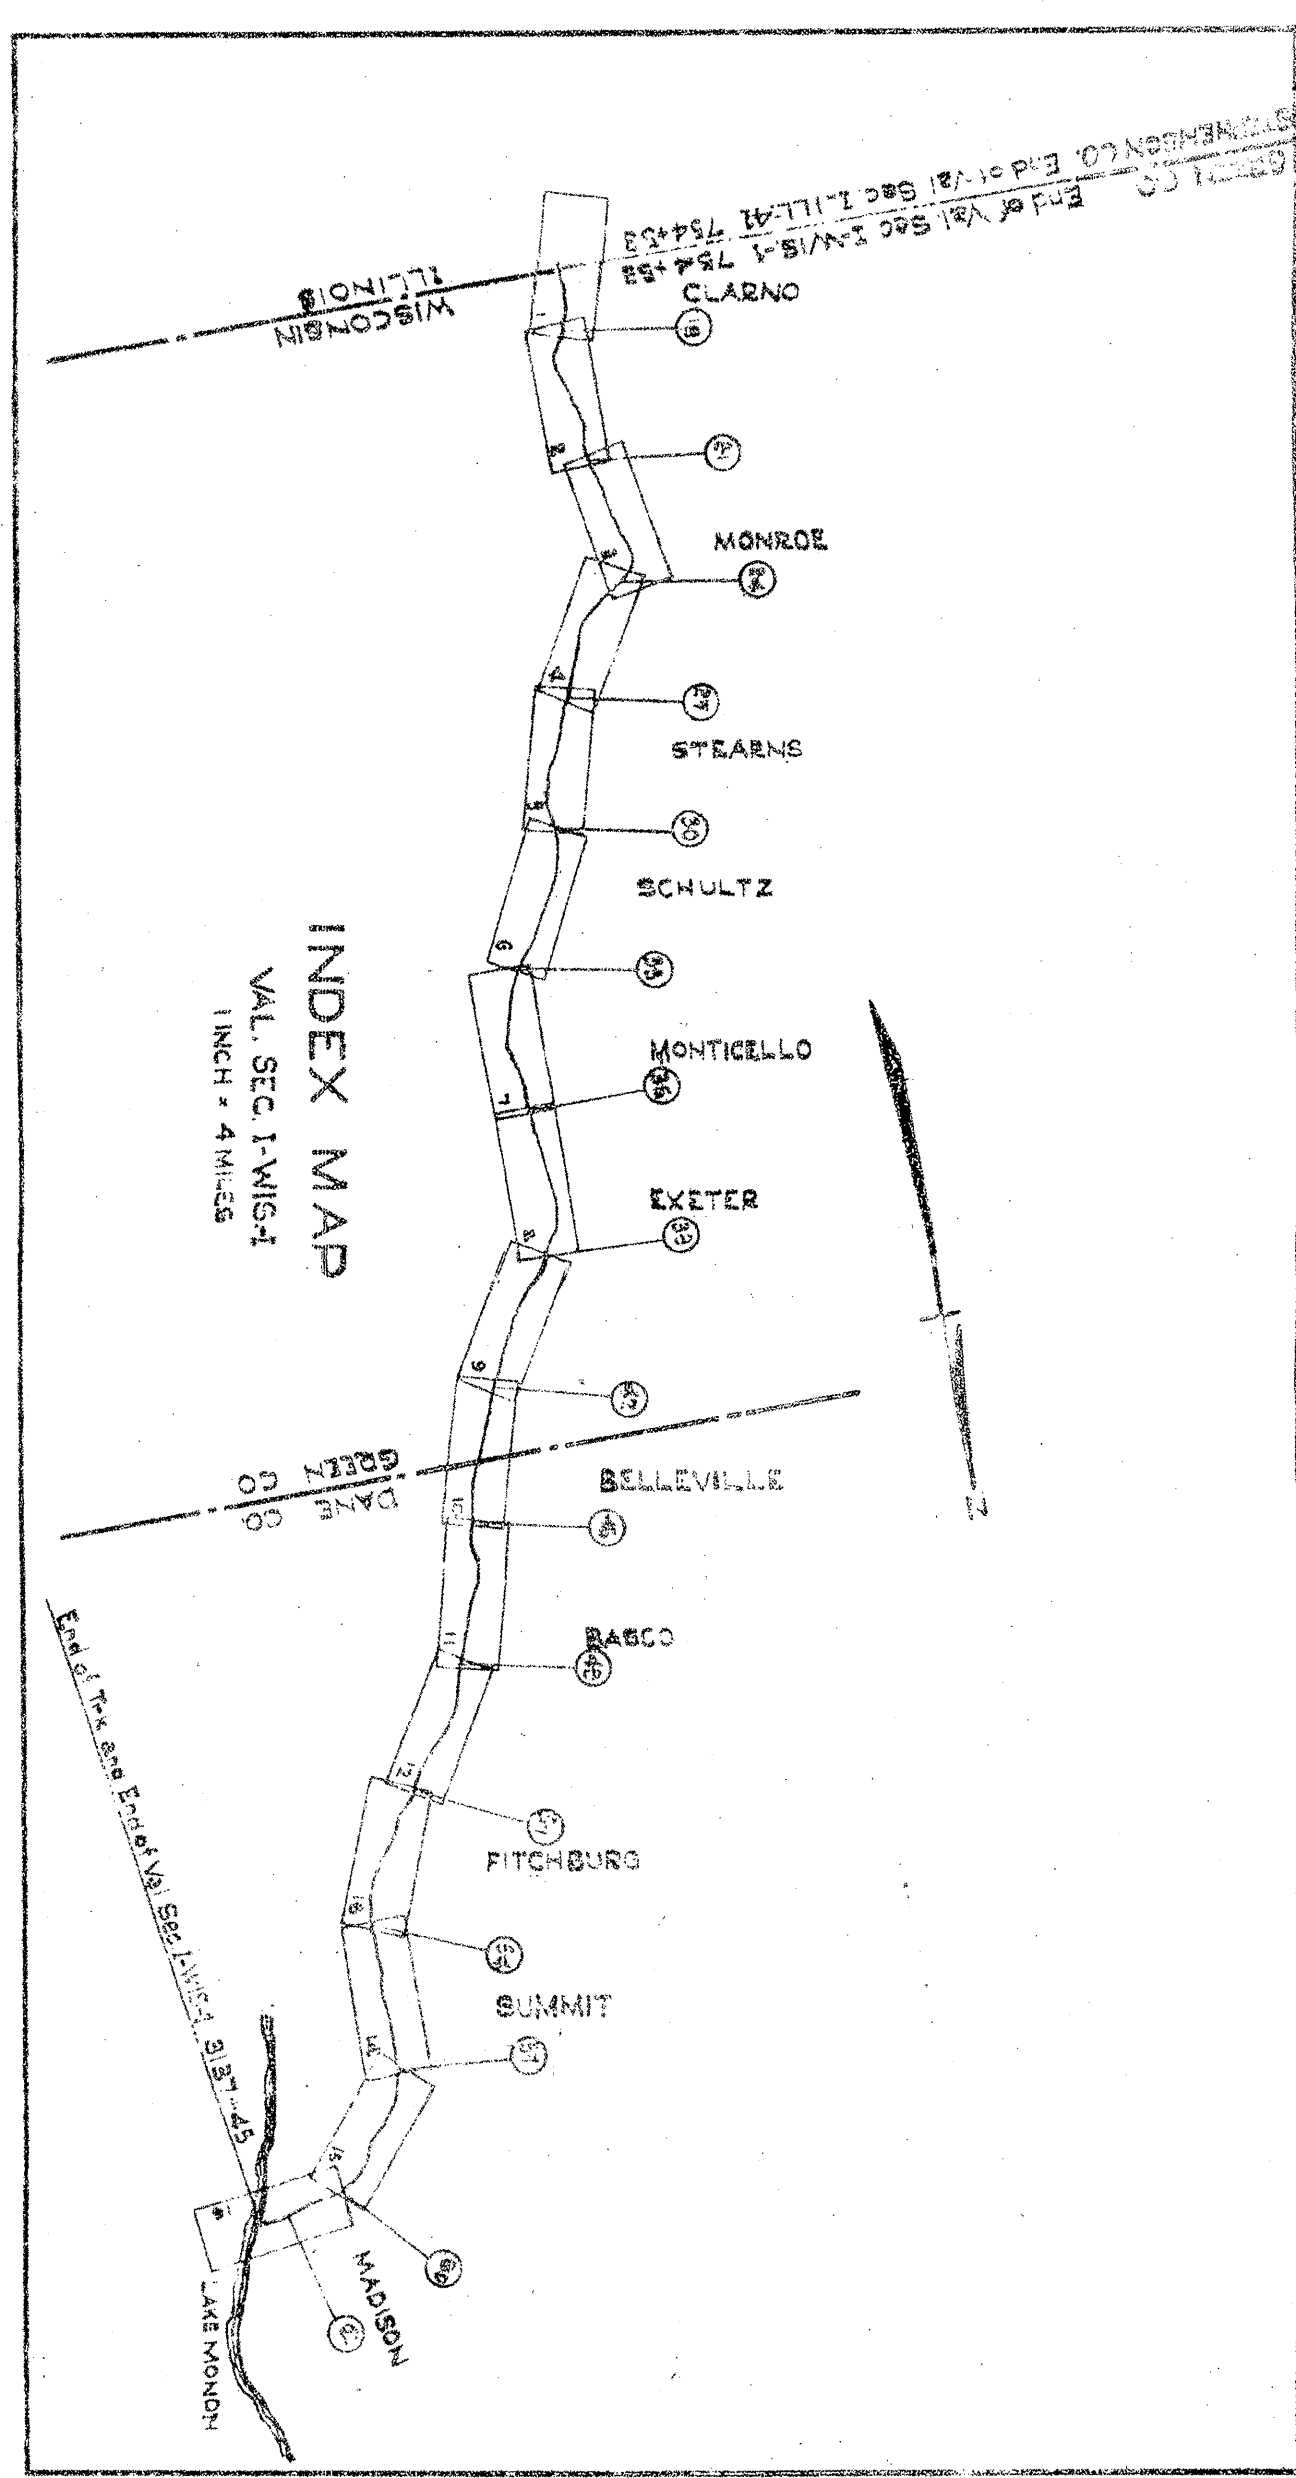


FIELD NOTES
E-W-WAY

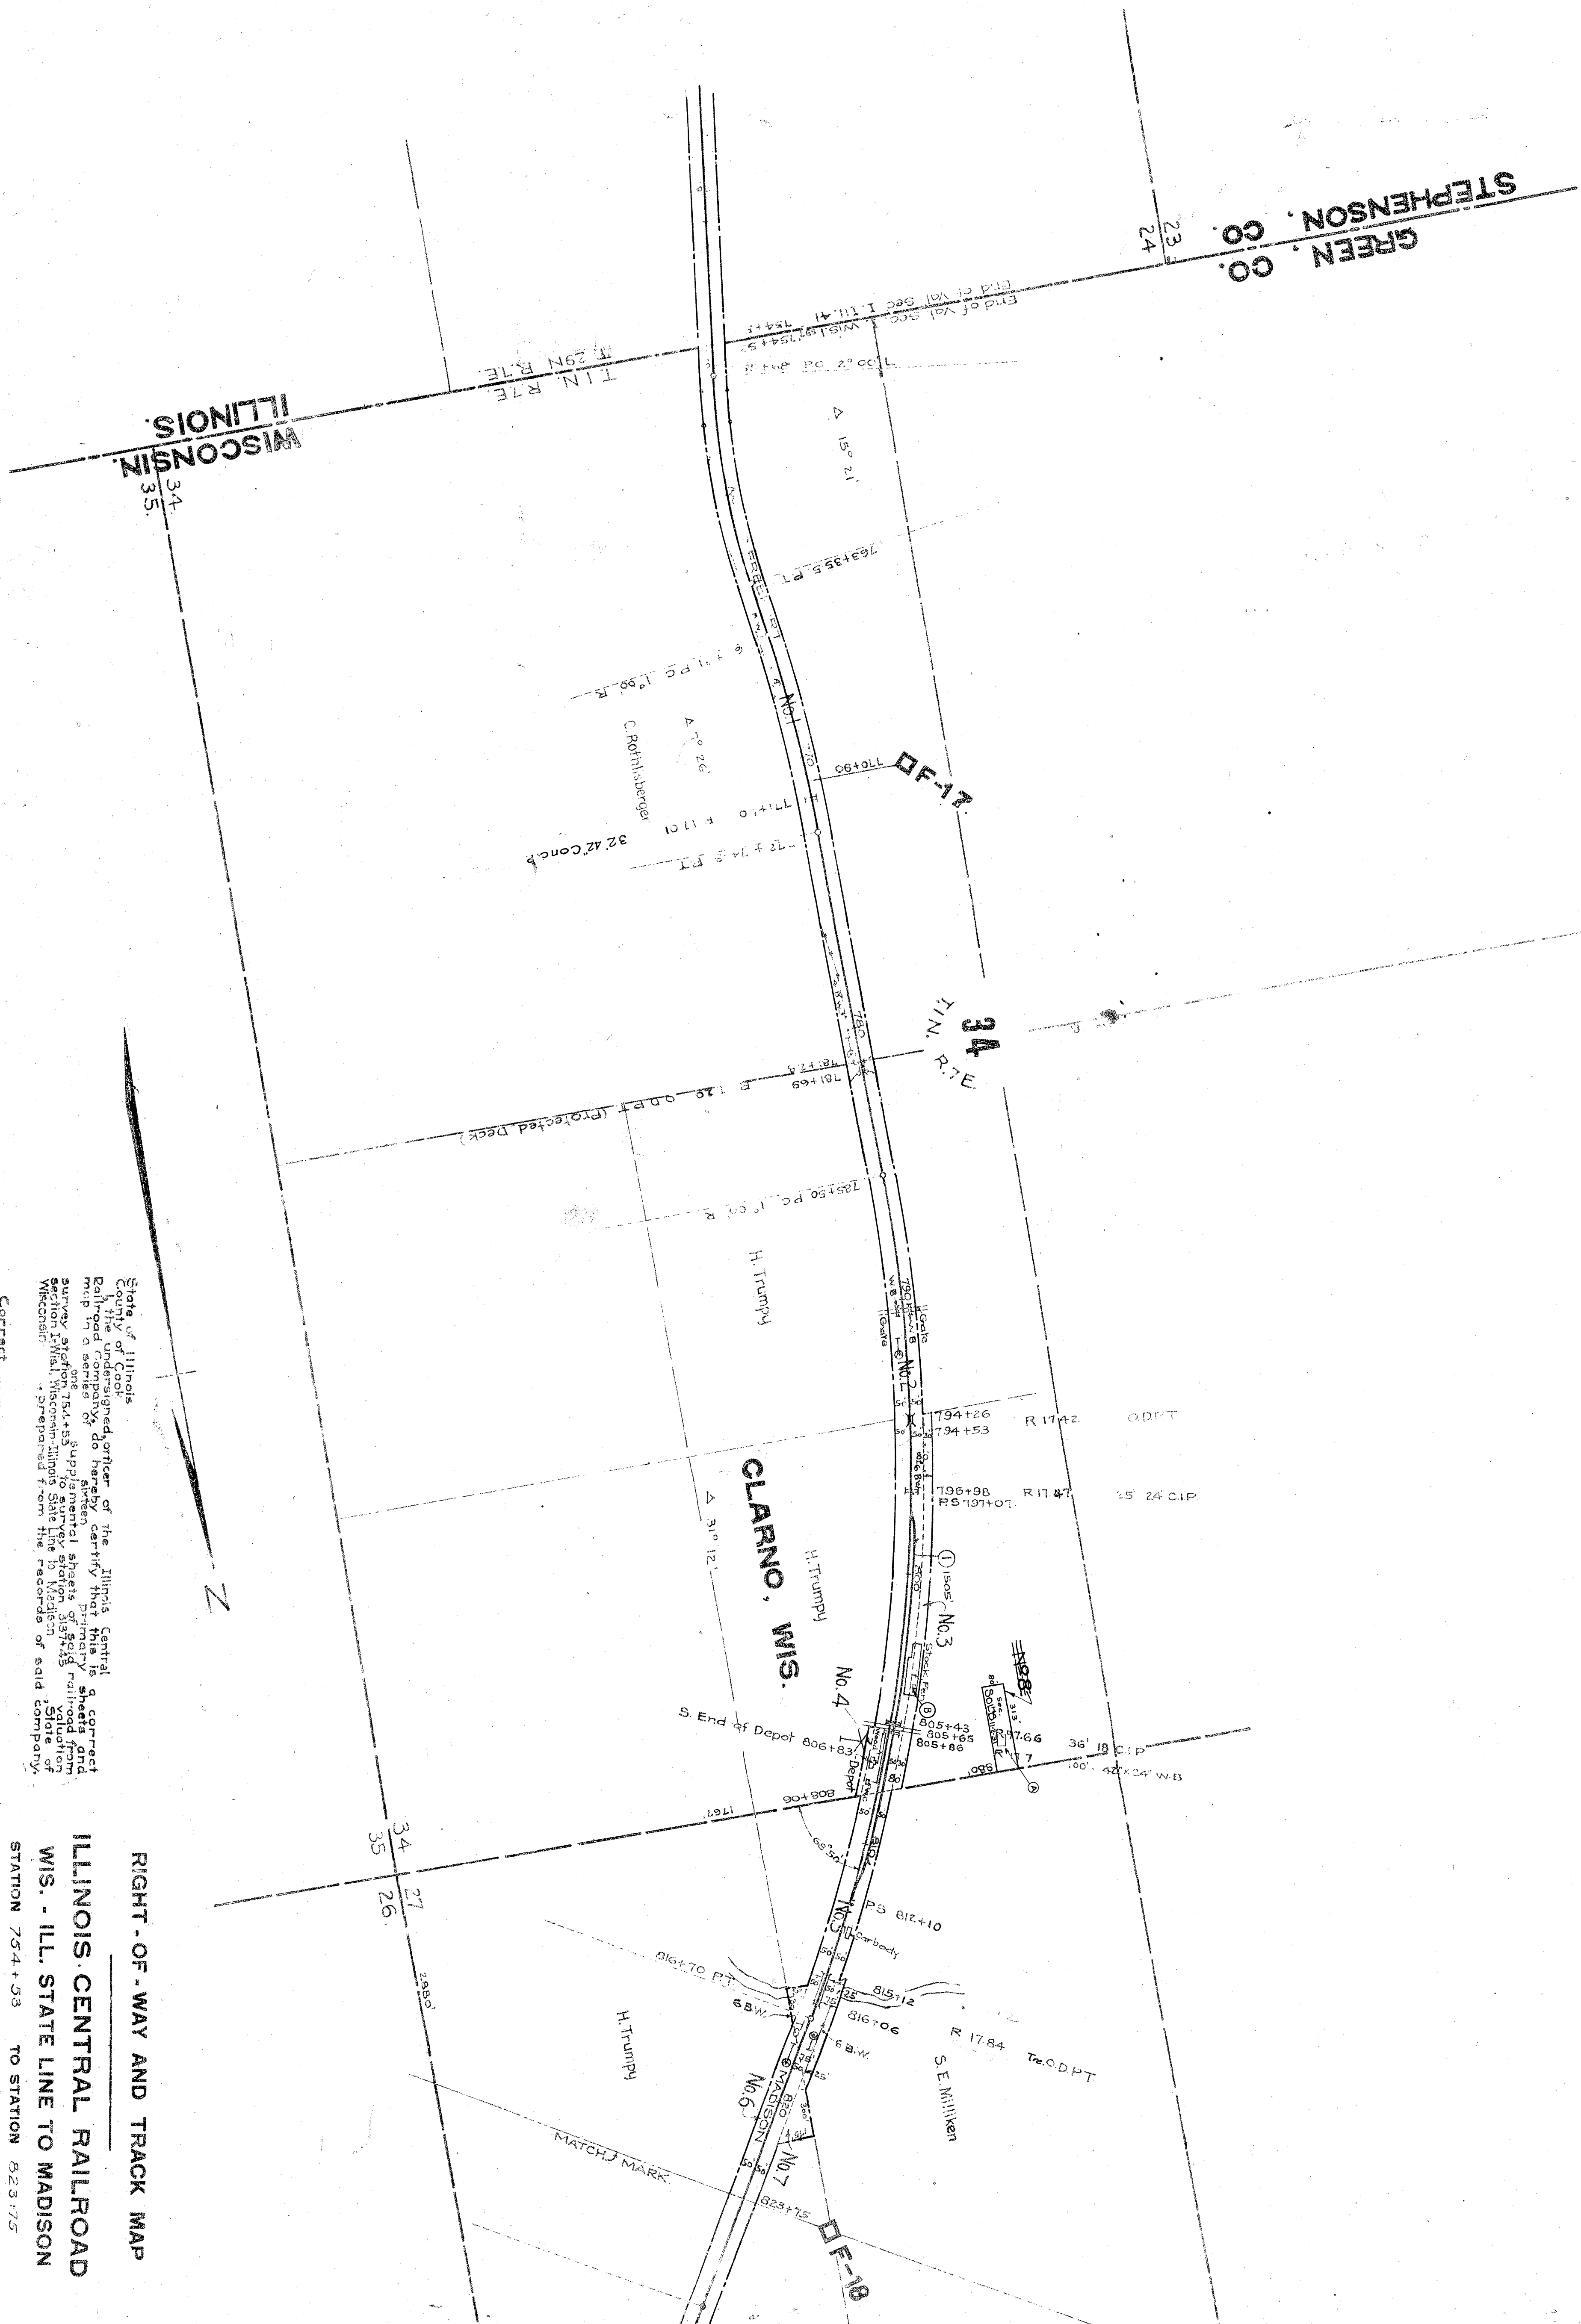

State of Illinois
County of Cook

RIGHT-OF-WAY AND TRACK MAP
ILLINOIS CENTRAL RAILROAD
WIS. - ILL. STATE LINE TO MADISON
1 MILE
1

 


Right of Way

| | |
|------------------------|-------------------------|

RIGHT-OF-WAY AND TRACK MAP
ILLINOIS CENTRAL RAILROAD
 WIS. - ILL. STATE LINE TO MADISON
 STATION 982+33 TO STATION 1141+00
 M. P. F21 TO M. P. F-24
 SCALE: 1" = 300 FT.
 OFFICE OF CHIEF ENGINEER
 CHICAGO, ILL.
 JUNE 30, 1915, REV. DEC. 1, 1932

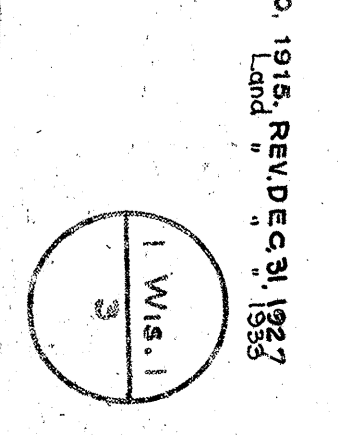

Sheet No. of Application Section Title, Wisconsin State Line
 to Survey Station 10-15-86
 M. P. F21
 Vanden Engineer

SOLD TO
WIS. DEPT. OF TRANS.
DEC. 29-1980 X 38000

| LINE | SECTION | STATION | DATE | REVISION | BY |
|------|--------------|--------------------|---------|----------|------|

STEARNS, WIS.


Right of Way East

| | | |
|------------------------|------|------------|
| 1290 + 00 to 1304 + 78 | 6.8W | Perm. Snow |
| 1357 + 20 to 1364 + 25 | 6.8W | Perm. Snow |
| 1364 + 25 to 1377 + 20 | 6.8W | Perm. Snow |
| 1377 + 20 to 1385 + 77 | 6.8W | Perm. Snow |
| 1385 + 77 to 1392 + 50 | 6.8W | Perm. Snow |
| 1392 + 50 to 1402 + 53 | 6.8W | Perm. Snow |

| NO. | MARK | DESCRIPTION | DATE |
|-----|---------|-------------|---------|
| 1 | 1392+50 | Stock Pens | 5-18-87 |
| 2 | 1394+15 | Stock Pens | 5-18-87 |
| 3 | 1395+00 | Stock Pens | 5-18-87 |
| 4 | 1395+00 | Stock Pens | 5-18-87 |
T2N
R7E
24

RIGHT-OF-WAY AND TRACK MAP
ILLINOIS CENTRAL RAILROAD
WIS. - ILL. STATE LINE TO MADISON
STATION 1290+00 TO STATION 1438+23
M. P. R. 27
SCALE: 1" = 300 FT.
OFFICE OF CHIEF ENGINEER
CHICAGO, ILL.
JUNE 30, 1915, REV. DEC. 31, 1983
TO M. P. R. 30

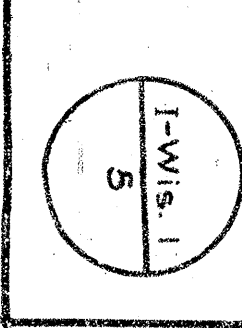

DRAWN BY J.E. 231

SOLD TO
WIS. DEPT. OF TRANS.
DEC. 29-1980, X-38000

 

| NO. WORK | DESCRIPTION | DATE COMPLETED |
|----------|-------------|----------------|
| | | |
| | | |
| | | |
| | | |
| | | |

- Fence Note -**
- R. of W. on East**
- 1471.192 to 1484.415 to 1471.191 4 B.W. 16' W.W.
 - 1484.415 to 1488.415 6 B.W.
 - 1488.415 to 1501.448 5 B.W.
 - 1501.448 to 1508.415 5 B.W.
 - 1508.415 to 1511.448 5 B.W. Perm. Snow.
 - 1511.448 to 1513.448 5 B.W.
 - 1513.448 to 1515.448 5 B.W. Perm. Snow.
 - 1515.448 to 1521.448 5 B.W.
 - 1521.448 to 1525.448 5 B.W.
 - 1525.448 to 1528.448 5 B.W.
 - 1528.448 to 1532.448 5 B.W.
 - 1532.448 to 1538.448 5 B.W.
 - 1538.448 to 1542.448 5 B.W. Perm. Snow.
 - 1542.448 to 1546.448 5 B.W.
 - 1546.448 to 1552.448 5 B.W. Perm. Snow.
 - 1552.448 to 1556.448 5 B.W.
 - 1556.448 to 1562.448 5 B.W.
 - 1562.448 to 1572.448 5 B.W.
 - 1572.448 to 1584.448 5 B.W.
 - 1584.448 to 1591.448 3 B.W. 16' W.W.
 - 1591.448 to 1601.448 3 B.W. 16' W.W.
 - 1601.448 to 1611.448 3 B.W. 16' W.W.
 - 1611.448 to 1616.448 3 B.W. 16' W.W.
- R. of W. on West**


| NO. | OWNER | ACREAGE | SECTION | SUBSECTION | DEPT. |
|-----|----------------------|---------|---------|------------|-------|

Right-of-Way and Track Map
ILLINOIS CENTRAL RAILROAD
WIS. - ILL. STATE LINE TO MADISON
STATION 1456+00 TO STATION 1616+00
M. P. F.-33
SCALE: 1" = 320 FT.
JUNE 20, 1915, REV. DEC. 31, 1927
OFFICE OF CHIEF ENGINEER,
CHICAGO, ILL.
DRAWN 1/2 25

SOLD TO
WIS. DEPT. OF TRANS.
DEC. 29-1980, X-38000

A-X-35757 Q.C.D. 8-8-74 M.R.R.

| SECTION | OWNER | SECTION | DATE | SECTION | DATE | SECTION | DATE |
|---------|---------------------|---------|---------|---------|--------|---------|------|
| 1 | M. E. TONE | C-14-83 | 5-14-87 | 62 | 62-82 | 4-13-87 | 68 |
| 2 | H. R. BOUTER & WIFE | " | 5-16-88 | 63 | 63-87 | 5-16-88 | 69 |
| 3 | " | " | " | 64 | 64-88 | 7-28-87 | 70 |
| 4 | H. R. BOUTER & WIFE | " | " | 65 | 65-89 | 7-28-87 | 71 |
| 5 | " | " | " | 66 | 66-89 | 7-28-87 | 72 |
| 6 | J. BOHLER & WIFE | " | " | 67 | 67-90 | 4-13-87 | 73 |
| 7 | H. R. BOUTER & WIFE | " | " | 68 | 68-90 | 4-13-87 | 74 |
| 8 | (COVERED) BOHLER | " | " | 69 | 69-91 | 4-13-87 | 75 |
| 9 | (COVERED) BOHLER | " | " | 70 | 70-91 | 4-13-87 | 76 |
| 10 | GEORGE EIMER | " | " | 71 | 71-92 | 4-13-87 | 77 |
| 11 | GEORGE EIMER | " | " | 72 | 72-93 | 4-13-87 | 78 |
| 12 | J. E. PRATT | " | " | 73 | 73-94 | 4-13-87 | 79 |
| 13 | " | " | " | 74 | 74-95 | 4-13-87 | 80 |
| 14 | M. HUTCHINS | " | " | 75 | 75-96 | 4-13-87 | 81 |
| 15 | " | " | " | 76 | 76-97 | 4-13-87 | 82 |
| 16 | P. SCHROEDER & WIFE | " | " | 77 | 77-98 | 4-13-87 | 83 |
| 17 | D. KENNEDY & WIFE | " | " | 78 | 78-99 | 4-13-87 | 84 |
| 18 | D. KENNEDY & WIFE | " | " | 79 | 79-00 | 4-13-87 | 85 |
| 19 | D. KENNEDY & WIFE | " | " | 80 | 80-01 | 4-13-87 | 86 |
| 20 | AMT. BOHLER & WIFE | " | " | 81 | 81-02 | 4-13-87 | 87 |

 

| NO. | DESCRIPTION | DATE |
|-----|-------------|------|
| 1 | REVISION | |
| 2 | REVISION | |
Fence Note -
R. of W. on West side of Madison River
1616+88 to 1617+30 3.0W 12.0NW
1617+30 to 1618+50 3.0W 12.0NW
1618+50 to 1619+50 3.0W 12.0NW
1619+50 to 1621+50 3.0W 12.0NW
1621+50 to 1623+50 3.0W 12.0NW
1623+50 to 1625+50 3.0W 12.0NW
1773+50 to 1775+50 3.0W 12.0NW


RIGHT-OF-WAY AND TRACK MAP
ILLINOIS CENTRAL RAILROAD
WIS. - ILL. STATE LINE TO MADISON
STATION 1616+58 TO STATION 1775+58
M. P. F-33 TO M. P. F-36
SCALE: 1" = 300 FT.
JUNE 30, 1915, REV. DEC. 31, 1927
OFFICE OF CHIEF ENGINEER,
CHICAGO, ILL.
DRAWN BY: A. J. ZIS
I-WIS-1
7


WIS. DEPT. OF TRANS.
DEC. 29, 1900. X-38000

A-138744 (COND.) 3-23-1921 to William F. Hudson

| Plan No. | Sheet No. | Locality |
|----------|-----------|----------|
| | | |
| | | |
 

| No. | Stationer | Corner | Section | Range | Township | County |
|-----|----------------------|--------|---------|-------|----------|--------|
| 1 | Mont. P. & M. Co. | | | | | |
| 2 | J. Moore & W. W. Co. | | | | | |
| 3 | J. Moore & W. W. Co. | | | | | |
Fence Note

R. of W. on West: 1884+30 to 1880+00 6 B.W.


SOLD TO
WIS. DEPT. OF TRANS.
DEC. 23, 1930, X-38000


| Sta. | Owner | Distance | Subst. | Dist. | Block | Cont. No. |
|------|---------------------|----------|--------|---------|--------|-----------|
| 1 | M. Schillier & Wife | 0.0 | W.D. | 1-21-47 | 62-434 | 2-2-47 |
| 2 | O. Kuby & Wife | 0.0 | W.D. | 1-21-47 | 62-434 | 2-2-47 |
| 3 | F. Laroque | 0.0 | W.D. | 1-21-47 | 62-434 | 2-2-47 |
| 4 | F. Haebley | 0.0 | W.D. | 1-21-47 | 62-434 | 2-2-47 |
| 5 | J. Stoley | 0.0 | W.D. | 1-21-47 | 62-434 | 2-2-47 |
| 6 | N. St. Park | 0.0 | W.D. | 1-21-47 | 62-434 | 2-2-47 |
| 7 | W.H. Rose | 0.0 | W.D. | 1-21-47 | 62-434 | 2-2-47 |
| 8 | C. Zwiefly | 0.0 | W.D. | 1-21-47 | 62-434 | 2-2-47 |
| 9 | Jacob Grunier | 0.0 | W.D. | 1-21-47 | 62-434 | 2-2-47 |
| 10 | M. H. Rose & Wife | 0.0 | W.D. | 1-21-47 | 62-434 | 2-2-47 |
| 11 | C. Parker & Wife | 0.0 | W.D. | 1-21-47 | 62-434 | 2-2-47 |
| 12 | Jacob Grunier | 0.0 | W.D. | 1-21-47 | 62-434 | 2-2-47 |
| 13 | Jacob Grunier | 0.0 | W.D. | 1-21-47 | 62-434 | 2-2-47 |

 

| Station | Dist. | Block | Cont. No. |
|----------|-------|----------|----------------|
| 1945+11 | to | 1954+63 | C. B. W. |
| 1947+00 | to | 1958+00 | G. B. W. |
| 1948+80 | to | 1967+05 | 3 B.W. 16 W.W. |
| 1951+85 | to | 1957+42 | 3 B.W. 16 W.W. |
| 1954+05 | to | 1957+10 | 3 B.W. 16 W.W. |
| 1957+10 | to | 1957+92 | G. B. W. |
| 1958+92 | to | 1964+95 | G. B. W. |
| 1961+45 | to | 1964+83 | Part Snow |
| 1964+83 | to | 1967+10 | 3 B.W. 16 W.W. |
| 1967+10 | to | 1981+58 | A. B. W. |
| 1981+58 | to | 1983+38 | G. B. W. |
| 1983+38 | to | 1985+00 | G. B. W. |
| 1985+00 | to | 1985+10 | 3 B.W. 16 W.W. |
| 1985+10 | to | 1985+72 | 3 B.W. 16 W.W. |
| 1985+72 | to | 1985+92 | G. B. W. |
| 1985+92 | to | 1986+43 | G. B. W. |
| 1986+43 | to | 1986+130 | 3 B.W. 16 W.W. |
| 1986+130 | to | 1987+35 | G. B. W. |
| 1987+35 | to | 1987+58 | G. B. W. |
| 1987+58 | to | 1987+58 | G. B. W. |


| NO. | DATE | DESCRIPTION |
|-----|---------|---|
| 1 | 1934-11 | Original map of the Illinois State Line |
| 2 | 1934-11 | Original map of the Illinois State Line |
RIGHT-OF-WAY AND TRACK MAP
ILLINOIS CENTRAL RAILROAD
WIS. - ILL. STATE LINE TO MADISON
STATION 1934-11 TO STATION 2093+38
M. P. F-39 TO M. P. F-42
SCALE: 1 IN. = 300 FT.
JUNE 30, 1916, REV. DEC. 31, 1927
OFFICE OF CHIEF ENGINEER
CHICAGO, ILL.

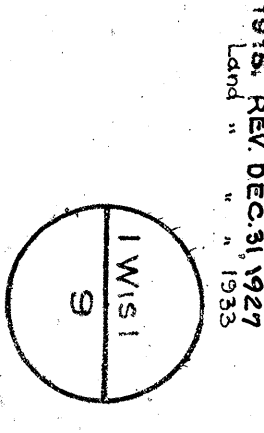

survey station 54+35 to survey station 54+35

M. P. F-39
Validation Engineer

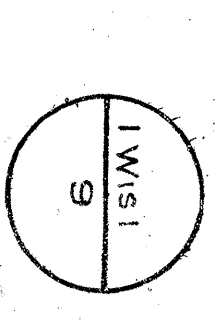


LAND CHANGES

| NO. | TRANSACTION | DATE | MFR. | X-NO. | AREA |
|-----|----------------------------------|------------|------|---------|--------|
| A | SOLD TO VILLAGE OF BELLEVILLE | 4-28-1982 | YES | X-30411 | 15,914 |
| B | SOLD TO EUGENE A. ROOSLI | 7-9-1983 | NO | X-14781 | 15,800 |
| C | SOLD TO AGRI-SWISS, INC. | 9-28-1970 | YES | X-35823 | |
| D | COOPERATIVE | 4-7-1975 | YES | X-35873 | |
| E | Village of Belleville | 11-3-1975 | YES | X-35873 | |
| F | to Agr-Swiss, Inc. | 5-31-1977 | YES | X-35936 | |
| G | to Union Cooperative Association | 11-18-1977 | YES | X-35936 | |
| H | to Union Cooperative Association | 12-5-1981 | YES | X-35816 | |
| J | to J.S. Hossy Lumber Co. | | | | |

| NO. | DESCRIPTION | DATE |
|-----|---------------|-----------|
| 1 | Original Plat | 12-1-1837 |
| 2 | Original Plat | 12-1-1837 |
SOLD TO
WIS. DEPT. OF TRANS.
DEC. 29-1980, X-38000

 

FENCE NOTES -
 R of W on West
 2033 + 38 to 2112 + 00 S.E.W.
 2112 + 00 to 2128 + 30 S.E.W.
 2128 + 30 to 2144 + 65 S.E.W.

DANE CO. GREEN CO.


BELLEVILLE, WIS.

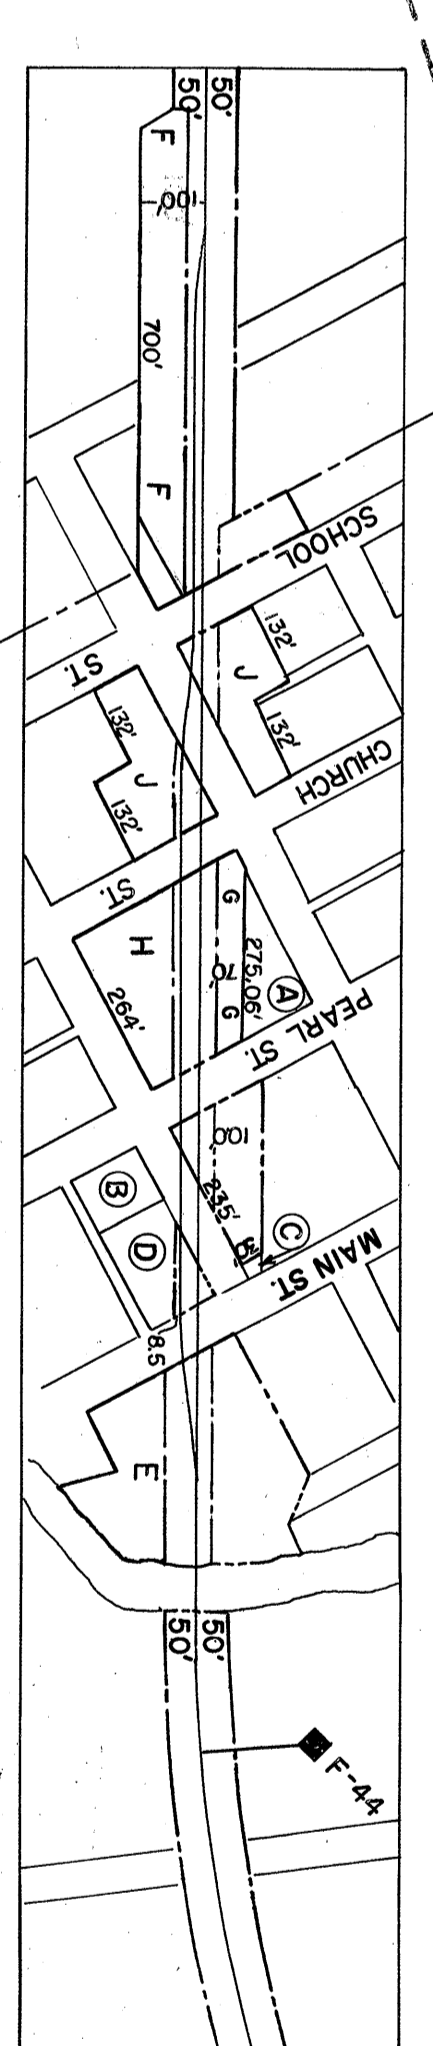

INSERT 1"=300'

| Lot | Owner | Area | Dist. | Record | Cont'd. | Remarks |
|-----|--------------------|------|---------|--------|---------|---------|
| 1 | W. P. Jones & Wife | 0.48 | 4-13-47 | 62-037 | 418-47 | 115 |

RIGHT-OF-WAY AND TRACK MAP
ILLINOIS CENTRAL RAILROAD
 WIS. - ILL. STATE LINE TO MADISON
 STATION 2093+95 TO STATION 2251+44
 M. P. F. 42 TO M. P. F. 43
 SCALE: 1" = 800 FT.
 OFFICE OF CHIEF ENGINEER
 CHICAGO, ILL.

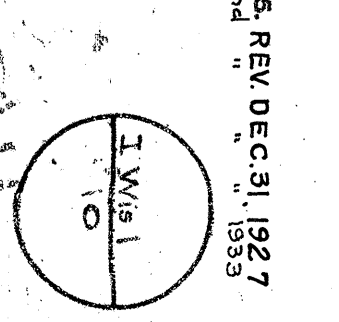


JUNE 20, 1916 REV. DEC. 31, 1927
 1"=800 FT.
 CHICAGO, ILL.

| PLAN | WORK | DESCRIPTION | DATE |
|------|--------------|-------------|------|
| 1 | CONSTRUCTION | | |
| 2 | CONSTRUCTION | | |
Factor Notes:
Stationing West
Stationing East

- 1868 + 78 to 2510 + 60 Perm. Snow
 2570 + 60 to 2574 + 00 58'W - 85'NW
 2574 + 00 to 2578 + 37 Perm. Snow
 2578 + 37 to 2586 + 27 58'W - 85'NW
 2586 + 27 to 2596 + 60 58'W - 85'NW
 2596 + 60 to 2601 + 64 78'W
 2601 + 64 to 2608 + 94 42'W - 85'NW
 2608 + 94 to 2620 + 00 83'W
 2620 + 00 to 2626 + 03 83'W
 2626 + 03 to 2630 + 18 83'W
 2630 + 18 to 2653 + 50 58'W - 78'NW
 2653 + 50 to 2675 + 88 63'W
 2675 + 88 to 2721 + 49 83'W - 85'NW
 2721 + 49 to 2731 + 09 58'W - 85'NW
 2731 + 09 to 2737 + 10 83'W - 78'NW
 2737 + 10 to 2738 + 49 78'W
 2738 + 49 to 2750 + 00 83'W
 2750 + 00 to 2759 + 07 83'W
 2759 + 07 to 2805 + 18 83'W
 2805 + 18 to 2814 + 23 78'W - 78'NW
 2814 + 23 to 2816 + 33 78'W - 78'NW
 2816 + 33 to 2819 + 49 83'W
 2819 + 49 to 2833 + 38 83'W
 2833 + 38 to 2839 + 09 58'W - 85'NW
 2839 + 09 to 2844 + 11 11'W - 25'W
 2844 + 11 to 2849 + 49 83'W - 78'NW
 2849 + 49 to 2871 + 21 11'W - 25'W
 2871 + 21 to 2871 + 49 83'W

 


Sheet No. of 15 of addition section 1/4 Sec. 18, Twp. 20 N., R. 20 W., of Madison County, Illinois, to survey station 754+33 to survey station 351+45.
 M. P. F. 51
 JUNE 20, 1980, REV. DEC. 31, 1982
 OFFICE OF CHIEF ENGINEER
 CHICAGO, ILL.

RIGHT-OF-WAY AND TRACK MAP
 ILLINOIS CENTRAL RAILROAD
 WIS. - ILL. STATE LINE TO MADISON
 STATION 2568+78 TO STATION 2727+49
 M. P. F. 51 TO M. P. F. 54
 SCALE: 1" = 800 FT.
 OFFICE OF CHIEF ENGINEER
 CHICAGO, ILL.
 JUNE 20, 1980, REV. DEC. 31, 1982


SOLD TO
WIS. DEPT. OF TRANSPORTATION
DEC. 29-1960, X-58000

A-133923 Elevation 4-7-1961 to State of Wisconsin
B-133924 (Original) 2-18-1962 to Neplus Contracting Co., Inc.

 

Force Notes

Left of Northwest

2171 + 48 to 2178 + 00 5.B.W.

2148 + 50 to 2164 + 42 5.B.W. - 26.W.W.

2168 + 08 to 2164 + 50 5.B.W.

2166 + 50 to 2175 + 50 5.B.W.

2175 + 50 to 2180 + 42 7.B.W.

2180 + 42 to 2190 + 18 4.B.W. - 26.W.W.

2191 + 28 to 2199 + 00 5.B.W.

2195 + 00 to 2800 + 00 5.B.W.

2800 + 00 to 2800 + 84 5.B.W. - 26.W.W.

2801 + 17 to 2810 + 82 5.B.W.

2813 + 50 to 2817 + 51 5.B.W.

2818 + 28 to 2842 + 73 5.B.W.

2848 + 00 to 2848 + 07 5.B.W.

2858 + 07 to 2876 + 40 5.B.W.

2877 + 90 to 2886 + 27 4.B.W.

2171 + 59 to 2178 + 50 7.B.W.

2178 + 50 to 2180 + 42 4.B.W. - 26.W.W.

2185 + 08 to 2195 + 19 5.B.W. - 26.W.W.

2195 + 00 to 2196 + 00 3.B.W. - 26.W.W.

2195 + 00 to 2196 + 00 3.B.W. - 26.W.W.

2195 + 00 to 2196 + 00 3.B.W. - 26.W.W.

2801 + 25 to 2810 + 52 5.B.W.

2810 + 52 to 2817 + 51 5.B.W.

2818 + 28 to 2842 + 73 5.B.W.

2848 + 00 to 2848 + 07 5.B.W.

2858 + 07 to 2876 + 40 5.B.W.

2877 + 90 to 2886 + 27 4.B.W.



























NOTE A
EASING TO MADISON GAS & ELECTRIC CO.
12" GAS PIPE LINE 7/16/70

| NO. | DESCRIPTION | DATE |
|-----|-------------------|-----------|
| 1 | CHANGING TRACKS | NOV. 1952 |
| 2 | REPAIRS TO TRACKS | NOV. 1952 |
| 3 | REPAIRS TO TRACKS | NOV. 1952 |
| NO. | DATE | DESCRIPTION | BY |
|-----|---------|-------------------------|---------------|
| 1 | 5-13-47 | 1. Mueller & Bise | C.M.A. & Bise |
| 2 | 5-21-47 | 2. Geo. Gillett & Bise | " |
| 3 | 5-21-47 | 3. Geo. Gillett & Bise | " |
| 4 | 5-21-47 | 4. J. O'Brien & Bise | " |
| 5 | 7-26-47 | 5. M. McKeene (Chicago) | " |
| 6 | 7-26-47 | 6. J. O'Brien & Bise | " |
| 7 | 4-16-47 | 7. J. Miesel & Bise | " |
| 8 | 4-16-47 | 8. H.C. Tieman & Bise | " |
| 9 | 11-7-47 | 9. H.C. Tieman & Bise | " |
| 10 | 11-7-47 | 10. H.C. Tieman & Bise | " |
| 11 | 4-23-47 | 11. H.C. Tieman & Bise | " |


Sheet No. 0716 of 8, Addition section Illinois-Madison State Line
of the Illinois Central Railroad Company, from
Station 2727+49 to Station 2896+27
Survey Station 15-53
Chicago, Ill.
J. Miesel
Civil Engineer

RIGHT-OF-WAY AND TRACK MAP
ILLINOIS CENTRAL RAILROAD
WIS. - ILL. STATE LINE TO MADISON
STATION 2727+49 TO STATION 2896+27
M. P. F. 54 TO M. P. F. 57
SCALE: 1" = 200 FT.
JUNE 30, 1954, REVISED 31, 1957
OFFICE OF CHIEF ENGINEER
CHICAGO, ILL.

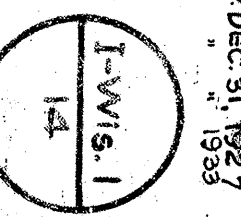

SOLD TO
 WIS. DEPT. OF TRANS.
 DEC. 29-1980, X38000


 


RIGHT-OF-WAY AND TRACK MAP
ILLINOIS CENTRAL RAILROAD
WIS. - ILL. STATE LINE TO MADISON
 STATION 2866+27 TO STATION 3044+03
 M. P. F. 57 TO M. P. F. 60
 SCALE: 1" = 200' FT.
 OFFICE OF CHIEF ENGINEER
 CHICAGO, ILL.

Sheet No. 0715 of Vol. 10 of Stationing Station 1714, Wisconsin-Illinois State Line
 to Madison of the Illinois Central Railroad Company, from
 survey station 751+53 to survey station 317+45.
 M. P. F. 57
 JUNE 20, 1915, REV. DEC. 31, 1927
 OFFICE OF CHIEF ENGINEER
 CHICAGO, ILL.

SOLD TO
 WIS. DEPT. OF TRANS.
 DEC. 29-1980, X-38000



- 1 X37364 (CDD) (Sd) 3-23-1978 D. S. Esenberg
- 2 X30639 WD 9-4-1991 Central Wisc. Co. - Food Stores
- 3 X32137 (CDD) (Sd) 10-31-1945 " "
- 4 6-30-1974 U-Haul Co. of Western Wis., Inc.
- 5 X36408 Eas. 11-20-1974 City of Madison, Wisc.
- 6 X38004 (CDD) (Sd) 5-23-1981 M. F. R. M. Miller
- 7 X38010 " " 5-23-1981 University of Wis. (Board of Regents)
- 8 X38235 " " 7-31-1981 Bro-Mar
- 9 X38477 " " 9-27-1982 University of Wis.
- 10 X39139 " " 9-27-1982 University of Wis. (Board of Regents)
- 11 X39675 " " 5-11-1983 University of Wis. (Board of Regents)
- 12 X39859 " " 10-31-1983 University of Wis. (Board of Regents)



STATION MAP - TRACKS AND STRUCTURES
ILLINOIS CENTRAL RAILROAD
MADISON, WIS.

STATION 5079+69 TO STATION 5137+45
 M. P. Fee TO M. P. 61.75
 SCALE 1" = 100 FT. LAND REV. FEB. 28, 1974
 JUNE 20, 1980. LAND REV. DEC. 31, 1983
 OFFICE OF CHIEF ENGINEER
 CHICAGO, ILL.

Sheet No. of a set of station maps, Wisconsin-Illinois State Line
 to Madison, Wisconsin, from
 Madison, Wisconsin, to
 survey station 5079+69

I-15-1
 S-16

MADISON WIS.

 

NOTE: NO BLDG. TO BE WITHIN 85' FROM TRACK. SEE L.A.T.
 DEED NO. 154-R-DANE CO. WIS. OR AFR. 2393

| LAND | CHANGES |
|------|---|
| A | WD. TO CITY OF MADISON, X-23852, 9-12-50 |
| B | O.C.D. TO CONSUMERS CO-OP SERVICES OF MADISON, X-28946, 4-15-46 |
| C | O.C.D. TO R.H. BEH. CARPENTER, X-28694, 7-31-45, M.R.R. |
| D | X-28292, 4-11-44, M.R.R. |
| E | X-27083, 11-4-38 |
| F | WD. TO J. FELDMAN, X-23853, 1-22-51, M.R.R. |
| G | WD. TO CENTRAL WISC. CO-OP FOOD STORES, X-28760, 10-31-45 |
| H | O.C.D. TO CITY OF MADISON, X-24719, 9-2-26 |
| I | WD. TO J. HEILPRIM, X-22761, 10-31-22 |
ILLINOIS CENTRAL RAILROAD
 RIGHT OF WAY AND TRACK MAP
 MADISON, WIS.

MILES R-61 & R-62
 LAND
 REVISED TO JAN. 1, 1954

