


State of Illinois
 County of Cook
 I, the undersigned, officer of the Chicago and North Western Railway do hereby certify that this is a correct map in a series of 22 primary sheets and 9 supplemental sheets of said railway from survey station 4847+62.4 to survey station 4920+00. Mr. Wisconsin Division, State of Wisconsin, prepared from the records of said company.
 Correct Valuation Engineer
[Signature]


Subscribed and sworn to before me, this 16th day of October, 1917.
 Notary Public in and for the State of Illinois
[Signature]
 My commission expires February 5, 1919.


RIGHT OF WAY AND TRACK MAP
 CHICAGO AND NORTH-WESTERN RAILWAY
 OPERATED BY THE
 C. & N. W. RY. CO.
 NORTHERN WISCONSIN DIVISION
 JANESVILLE, WIS. TO FONDDU LAC, WIS.
 STA. 4841+62.4 TO STA. 5052+82
 SCALE: 1 IN. = 400 FT.
 OFFICE OF CHIEF ENGINEER
 CHICAGO, ILL.
 JUNE 30, 1917




 



Sheet No. 2, of 22, Primary sheets
and 9, Supplemental sheets
of C. & N. W. Ry. from survey
Station 5052+82 to survey station 5264+02

RIGHT OF WAY AND TRACK MAP
CHICAGO AND NORTH-WESTERN RAILWAY
OPERATED BY THE
C. & N. W. RY. CO.
NORTHERN WISCONSIN DIVISION
JANESVILLE, WIS. TO FOND DU LAC, WIS.
STA. 5052+82 TO STA. 5264+02
SCALE: 1/2" = 400'-FT.
OFFICE OF CHIEF ENGINEER
CHICAGO, ILL.

W. D. ...
Division Engineer

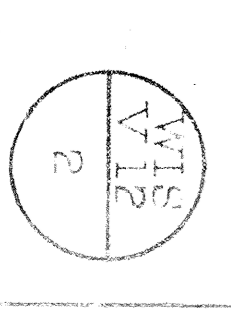




NO.	NAME	DATE	REVISION	BY	DATE	REVISION	BY

RIGHT OF WAY AND TRACK MAP
 CHICAGO AND NORTH-WESTERN RAILWAY
 OPERATED BY THE
 C. & N. W. RY. CO.
 NORTHERN WISCONSIN DIVISION
 JANEVILLE, WIS. TO FONDDU LAC, WIS.
 STA. 5264+02 TO STA. 5475+22
 SCALE: 1 IN. = 400 FT.
 OFFICE OF CHIEF ENGINEER
 CHICAGO, ILL.

Sheet No. 3 of 22 Primary sheets
 and 9 supplemental sheets
 of C. & N. W. RY. from survey
 station 5264+02 to survey station 5475+22

Lake Koshkonong

 


NO.	SECTION	DATE	BOOK	PAGE	DATE	BY	REMARKS	A.C. NO.
1	Possessory title							
Sheet No. 4 of 22 Primary sheets and 9 supplemental sheets of C.S.N.W.R.Y. from survey of station 5475+22 to station 5686+42

RIGHT OF WAY AND TRACK MAP
CHICAGO AND NORTH-WESTERN RAILWAY
OPERATED BY THE
C. & N. W. RY. CO.
NORTHERN WISCONSIN DIVISION
JANESVILLE, WIS. TO FOND DU LAC, WIS.

SCALE: 1 IN. = 400 FT.
JUNE 30, 1917
OFFICE OF CHIEF ENGINEER
CHICAGO, ILL.

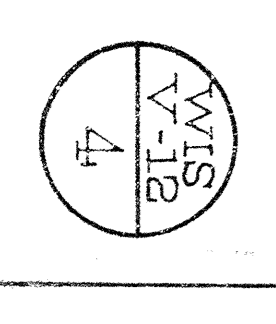



 


NO.	SM. NO.	OWNER	INTEREST	E. A. C.	DATE	AMOUNT	REMARKS
1	1	James S. Morrison	1/2 D.	July 1, 1899	100	100	By purchase only
2	2	Edward H. Hoo	1/2 D.	June 22, 1899	100	100	By purchase only
3	3	Asst. Secy. H. H.	1/2 D.	July 1, 1899	100	100	By purchase only

RIGHT OF WAY AND TRACK MAP
 CHICAGO AND NORTH-WESTERN RAILWAY
 OPERATED BY THE
 C. & N. W. RY. CO.
 NORTHERN WISCONSIN DIVISION
 JANESVILLE, WIS. TO FOND DU LAC, WIS.
 STA. 5686+86 TO STA 5897+62
 SCALE: 1 IN. = 400 FT.
 OFFICE OF CHIEF ENGINEER
 CHICAGO, ILL. JUNE 30, 1917

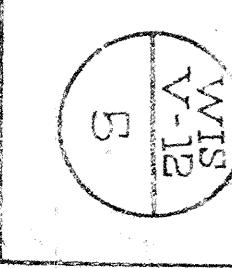


PLOTTED - 1894-08-13 1897
 RECORDED - 1894-04-13 1897
 CHECKED - 1894-05-23 1897

 

NO.	NAME	DATE	REVISION
1	Jan F. Smith	July 2, 1895	Page 1
2	John A. Hart	July 2, 1895	Page 2

Sheet No. 6 of 22 Primary Sheets
 and 9 Supplemental Sheets
 of C. & N. W. Ry. from survey
 station 5897+62 to survey station 6108+82

RIGHT OF WAY AND TRACK MAP
CHICAGO AND NORTH-WESTERN RAILWAY
 OPERATED BY THE
C. & N. W. RY. CO.
NORTHERN WISCONSIN DIVISION
JANESVILLE, WIS. TO FONDDU LAC, WIS.
 STA. 5897+62 TO STA. 6108+82
 SCALE: 1 IN. = 400 FT.
 OFFICE OF CHIEF ENGINEER
 CHICAGO, ILL.
 JUNE 30, 1917

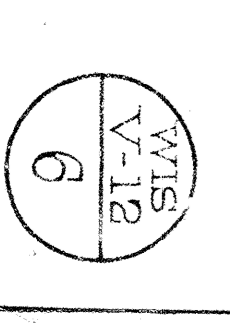

DATE: 4-5-1917
 DRAWN BY: J. W. RYAN
 CHECKED BY: J. W. RYAN



NO.	SECTION	DATE	BY	REVISION	DATE
1	Original	June 21, 1899	J. W. Ryan		
2	Original	Aug. 15, 1899	J. W. Ryan		
3	Original	Apr. 2, 1900	J. W. Ryan		
4	Original	Apr. 2, 1900	J. W. Ryan		
RIGHT OF WAY AND TRACK MAP
 CHICAGO AND NORTH-WESTERN RAILWAY
 OPERATED BY THE
 C. & N. W. RY. CO.
 NORTHERN WISCONSIN DIVISION
 JANESVILLE, WIS. TO FONDDU LAC, WIS.
 STA. 6108+82 TO STA. 6320+02
 SCALE: 1" = 400'-FT.
 OFFICE OF CHIEF ENGINEER
 JUNE 30, 1917
 CHICAGO, ILL.

Sheet No. 7 of 22 Primary sheets
 and 9 Supplemental sheets
 of C. & N. W. Ry from survey
 station 6108+82 to station 6320+02

J. W. Ryan
 Valuation Engineer

PLATTED - 2 P. 5 - APR 17, 1917
 TRACED - 6 P. 5 - MAY 21, 1917
 CHECKED - 1 P. 5 - MAY 28, 1917




NO.	OWNER	DATE	REMARKS
1	Private Owner	July 19, 1893	
2	Private Owner	July 19, 1893	
Sheet No. 8 of 22 Primary sheets
 and 9 supplemental sheets
 of C&N.W.R.R. from survey
 Station 6320+02 to survey station 6531+22

RIGHT OF WAY AND TRACK MAP
CHICAGO AND NORTH-WESTERN RAILWAY
 OPERATED BY THE
C. & N. W. RY. CO.
NORTHERN WISCONSIN DIVISION
JANESVILLE, WIS. TO FOND DU LAC, WIS.

SCALE: 1 IN. = 400 FT.
 OFFICE OF CHIEF ENGINEER
 CHICAGO, ILL.
 JUNE 30, 1917

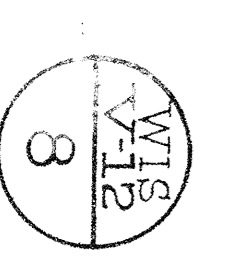

PLATTED - R.F.A. APR 23, 1917
 RECORDED - G.E.R. MAY 21, 1917
 CHECKED - R.F.S. MAY 24, 1917

 


NO.	OWNER	ACREAGE	DATE	BOOK	PAGE	REMARKS
1	Ernest Albert	1.70	June 20, 1897	160	117	1897
2	John Schmidt	1.70	July 5, 1899	116	117	1899
3	John Schmidt, Co. & Co.	1.70	Aug. 31, 1899	116	117	1899
4	John Schmidt, Co. & Co.	1.70	July 31, 1899	116	117	1899
5	John Schmidt	1.70	July 31, 1899	116	117	1899

RIGHT OF WAY AND TRACK MAP
 CHICAGO AND NORTH-WESTERN RAILWAY
 OPERATED BY THE
 C.&N.W.RY. CO.
 NORTHERN WISCONSIN DIVISION
 JANESVILLE, WIS. TO FONDDULAC, WIS.
 STA. 6531+22 TO STA. 6742+42
 SCALE: 1 IN. = 400 FT.
 OFFICE OF CHIEF ENGINEER
 CHICAGO, ILL.

Sheet No. 9 of 22. Primary sheets
 and 9 supplemental sheets
 of C&N.W.R.Y. from survey
 stations 6531+22 to survey station 6742+42

W. H. ...
 Valuation Engineer

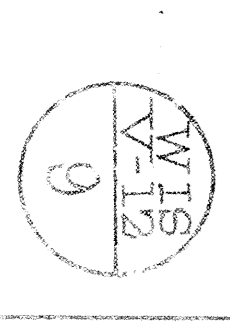


NO.	OWNER	ACQUISITION	D. & E.	RECORD	DATE	REMARKS	A. B. E. A.
1	Jacob Adam	W. D.	July 7, 1859	122	July 7, 1859	Part of lot covered by 1155	13000
Sheet No. 10 of 22 Primary Sheets
 and 9 Supplemental Sheets
 of C. & N. W. R. Y. from Survey
 Station 6742+42 to Station 6953+62
 Valuation Engineer
 JUNE 30, 1917


RIGHT OF WAY AND TRACK MAP
CHICAGO AND NORTH-WESTERN RAILWAY
 OPERATED BY THE
C. & N. W. R. Y. CO.
NORTHERN WISCONSIN DIVISION
JANESVILLE, WIS. TO FONDDU LAC, WIS.
 STA. 6742+42 TO STA. 6953+62
 SCALE: 1 IN. = 400 FT.
 OFFICE OF CHIEF ENGINEER
 CHICAGO, ILL.

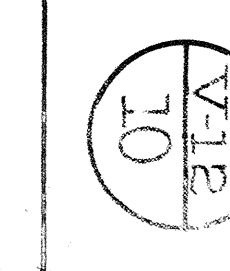

PLATTED: 25 MAY 1927
 RECORDED: 25 MAY 1927
 CHECKED: 25 MAY 1927





NO.	OWNER	DATE	RECORD	REMARKS
1	David Flanagan	June 4, 1892	187	July 1, 1892
2	Catherine Flanagan	June 17, 1892	210	June 29, 1892
3	Sam Flanagan	June 17, 1892	210	June 29, 1892
4	Sam Flanagan	June 17, 1892	210	June 29, 1892
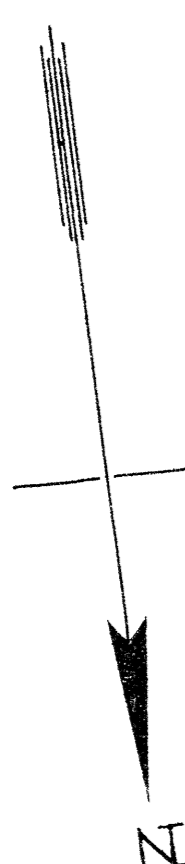

Sheet No. 11 of 22 Primary sheets
 and 9 supplemental sheets
 of C. & N.W. RY from survey
 station 68336 to station 71644+82


RIGHT OF WAY AND TRACK MAP
CHICAGO AND NORTH-WESTERN RAILWAY
 OPERATED BY THE
C. & N.-W. RY. CO.
NORTHERN WISCONSIN DIVISION
JANESVILLE, WIS. TO FONDDU LAC, WIS.
 STA. 6953+67 TO STA. 7164+82
 SCALE: 1 IN. = 400-FT.
 JUNE 30, 1917
 OFFICE OF CHIEF ENGINEER
 CHICAGO, ILL.

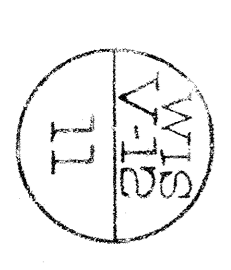

 


NO.	NAME	DATE	REMARKS
1	Edward H. Jones	June 21, 1897	Survey
2	John Chappell	June 21, 1897	Survey
3	Ed. Roberts, Jr.	June 21, 1897	Survey
4	Thomas Hodges	June 21, 1897	Survey
5	Alex. Ramsey	June 21, 1897	Survey

RIGHT OF WAY AND TRACK MAP
 CHICAGO AND NORTH-WESTERN RAILWAY
 OPERATED BY THE
 C. & N. W. RY. CO.
 NORTHERN WISCONSIN DIVISION
 JANESVILLE, WIS. TO FOND DU LAC, WIS.
 STA. 7164+82 TO STA. 7360+82
 SCALE: 1" = 400'-FT.
 OFFICE OF CHIEF ENGINEER
 CHICAGO, ILL.

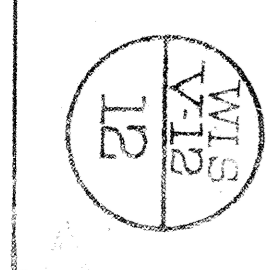

NO.	DATE	REVISION	BY	REASON

 



RIGHT OF WAY AND TRACK MAP
 CHICAGO AND NORTH-WESTERN RAILWAY
 OPERATED BY THE
 C. & N. W. RY. CO.
 NORTHERN WISCONSIN DIVISION
 JANESVILLE, WIS. TO FONDDU LAC, WIS.
 STA. 7360+82 TO STA. 7573+73
 SCALE: 1 in. = 400 FT.
 OFFICE OF CHIEF ENGINEER
 CHICAGO, ILL.

SHEET NO. 13 OF 22 PRIMARY SHEETS
 AND 9 SUPPLEMENTAL SHEETS
 OF C. & N. W. RY. FROM SURVEY
 STATION TO SURVEY STATION

JAMES H. HANCOCK
 Validation Engineer


JUNE 30, 1917

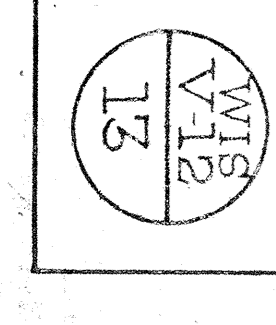

 



SECTION	DATE	BY	REMARKS
1	June 6, 1897	R. D.	Initial Survey

Sheet No. 14 of 22 Primary sheets
and 9 Supplemental sheets
of C. & N. W. Ry. from survey
Station 7572+02 to survey station 7783+22

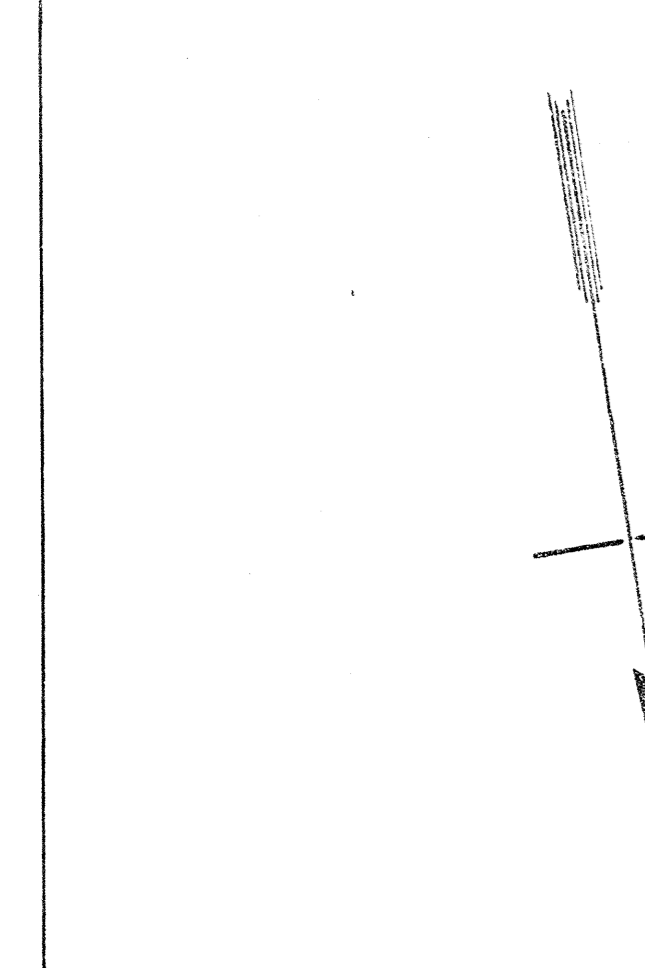

RIGHT OF WAY AND TRACK MAP
CHICAGO AND NORTHWESTERN RAILWAY
OPERATED BY THE
C. & N. W. RY. CO.
NORTHERN WISCONSIN DIVISION
JANESVILLE, WIS. TO FOND DU LAC, WIS.
STA. 7572+02 TO STA. 7783+22
SCALE: 1 IN. = 400 FT.
OFFICE OF CHIEF ENGINEER
CHICAGO, ILL.
JUNE 30, 1917

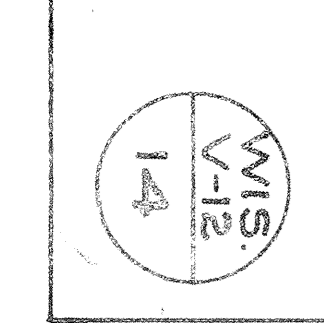

 



NO.	DATE	BY	REVISION	REMARKS
1	11. 11. 1917	H. R. Pugh		Original

Sheet No. 15 of 22 Primary sheets
and 9 supplemental sheets
of C&N.W.R.Y. from survey
station 7783+22 to survey station 7994+42

RIGHT OF WAY AND TRACK MAP
CHICAGO AND NORTH-WESTERN RAILWAY
OPERATED BY THE
C. & N. W. RY. CO.
NORTHERN WISCONSIN DIVISION
JANESVILLE, WIS. TO FONDDU LAC, WIS.

SCALE: 1 IN. = 400 FT.
OFFICE OF CHIEF ENGINEER
CHICAGO, ILL.
JUNE 30, 1917

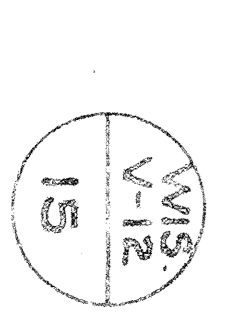

 

NO.	NAME	DATE	BY	REVISION
1	Richard P. Gilford	Jan. 4, 1883	K	
2	Richard P. Gilford	Jan. 4, 1883	K	
3	Arthur G. Young	Jan. 13, 1884	M	
4	Arthur G. Young	Jan. 13, 1884	M	
5	William Keagy	Sept. 17, 1884	M	
6	William Keagy	Sept. 17, 1884	M	
7	Amos Knapp	Aug. 21, 1882	M	
8	Frederick S. Wood	Mar. 24, 1884	M	
9	Hollister Wright	Mar. 24, 1884	M	
10	Hollister Wright	Mar. 24, 1884	M	
11	Thomas Smith	Aug. 21, 1882	M	

RIGHT OF WAY AND TRACK MAP
 CHICAGO AND NORTH-WESTERN RAILWAY
 OPERATED BY THE
 C. & N. W. RY. CO.
 NORTHERN WISCONSIN DIVISION
 JANESVILLE, WIS. TO FONDDU LAC, WIS.
 STA. 7994+42 TO STA. 8205+62
 SCALE: 1 IN. = 400 FT.
 OFFICE OF CHIEF ENGINEER
 CHICAGO, ILL.
 JUNE 30, 1917

Sheet No. 16 of 22 Primary sheets
 and 9 supplemental sheets
 of C. & N. W. RY. from survey
 station 7994+42 to survey station 8205+62


W. H. R. W. W.
 Valuation Engineer

DATE: 6-23-1917
 CHECKED: [Signature]



NO.	GRANTOR	GRANTEE	RECORD	DATE	REMARKS	AREA


RIGHT OF WAY AND TRACK MAP
 CHICAGO AND NORTH-WESTERN RAILWAY
 OPERATED BY THE
 C. & N.-W. RY. CO.
 NORTHERN WISCONSIN DIVISION
 JANESVILLE, WIS. TO FOND DU LAC, WIS.
 STA. 8205+62 TO STA. 8416+82
 SCALE: 1 IN. = 400-FT.
 JUNE 30, 1917
 OFFICE OF CHIEF ENGINEER
 CHICAGO, ILL.

 

NO.	DESCRIPTION	DATE	BY	REVISION	DATE	BY	REVISION
1	As Shown	1913	W. J. ...	1	1913	W. J. ...	1

RIGHT OF WAY AND TRACK MAP
 CHICAGO AND NORTH-WESTERN RAILWAY
 OPERATED BY THE
 C. & N. W. RY. CO.
 NORTHERN WISCONSIN DIVISION
 JANESVILLE, WIS. TO FOND DU LAC, WIS.
 STA. 8416+00 TO STA. 8628+00
 SCALE: 1" = 400'-FT.
 OFFICE OF CHIEF ENGINEER
 CHICAGO, ILL.


SHEET NO. 18 OF 22 PRIMARY SHEETS
 AND 9 SUPPLEMENTAL SHEETS
 OF C. & N. W. RY. FROM SURVEY
 STATION 8416+00 TO SURVEY STATION 8628+00

 

NO.	GRANTEE	DATE	RECORDED	DATE	BY	ACRES	APPROX. AREA
1	Edward Hansen	June 15, 1892	74	June 15, 1892	W. D.	1.12	1.12
2	Kilburn Hanson	June 15, 1892	75	June 15, 1892	W. D.	4.95	4.95
3	Spencer L. Carter	July 30, 1892	8	July 30, 1892	W. D.	1.35	1.35
4	Passaway Title	June 19, 1892	40	June 19, 1892	W. D.	1.35	1.35
5	Thomas H. Condit	June 19, 1892	40	June 19, 1892	W. D.	1.35	1.35

RIGHT OF WAY AND TRACK MAP
 CHICAGO AND NORTH-WESTERN RAILWAY
 OPERATED BY THE
 C. & N. W. RY. CO.
 NORTHERN WISCONSIN DIVISION
 JANESVILLE, WIS. TO FONDDULAC, WIS.
 STA. 8628+02 TO STA. 8839+22
 SCALE: 1 IN. = 400 FT.
 OFFICE OF CHIEF ENGINEER
 CHICAGO, ILL.
 JUNE 30, 1917

PREPARED BY: CHIEF ENGINEER
 CHECKED BY: JULY 11, 1917

 



NO.	SECTION	DATE	BY	REVISION	REMARKS
1	General	1917	W. J. ...		
2		
3		
4		
5		
6		
7		
8		
9		
10		
11		
12		
13		
14		
15		

RIGHT OF WAY AND TRACK MAP
 CHICAGO AND NORTH-WESTERN RAILWAY
 OPERATED BY THE
 C.&N.W.R.Y. CO.
 NORTHERN WISCONSIN DIVISION
 JANESVILLE, WIS. TO FOND DU LAC, WIS.

Sheet No. 20 of 22 Primary sheets
 and 9 Supplemental sheets
 of C.&N.W.R.Y. from Survey
 Station 8839+22 to Station 9050+42

SCALE: 1 IN. = 400 FT.
 JUNE 30, 1917
 OFFICE OF CHIEF ENGINEER
 CHICAGO, ILL.

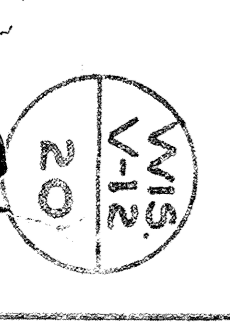


 

NO.	DATE	DESCRIPTION	BY	CHECKED
1	Sept 1, 1917	Survey	W. H.
2	Sept 1, 1917
3	Sept 1, 1917
Sheet No. 21 of 22 Primary sheets
and 2 supplemental sheets
of C. & N.W.R.R. from survey
station 9050+42 to survey station 9212+04.

RIGHT OF WAY AND TRACK MAP
CHICAGO AND NORTH-WESTERN RAILWAY
OPERATED BY THE
C. & N.W.R.R. CO.
NORTHERN WISCONSIN DIVISION
JANESVILLE, WIS. TO FOND DU LAC, WIS.
STA. 9050+42. TO STA. 9212+04.
SCALE: 1" = 400'-FT.
JUNE 30, 1917
OFFICE OF CHIEF ENGINEER
CHICAGO, ILL.

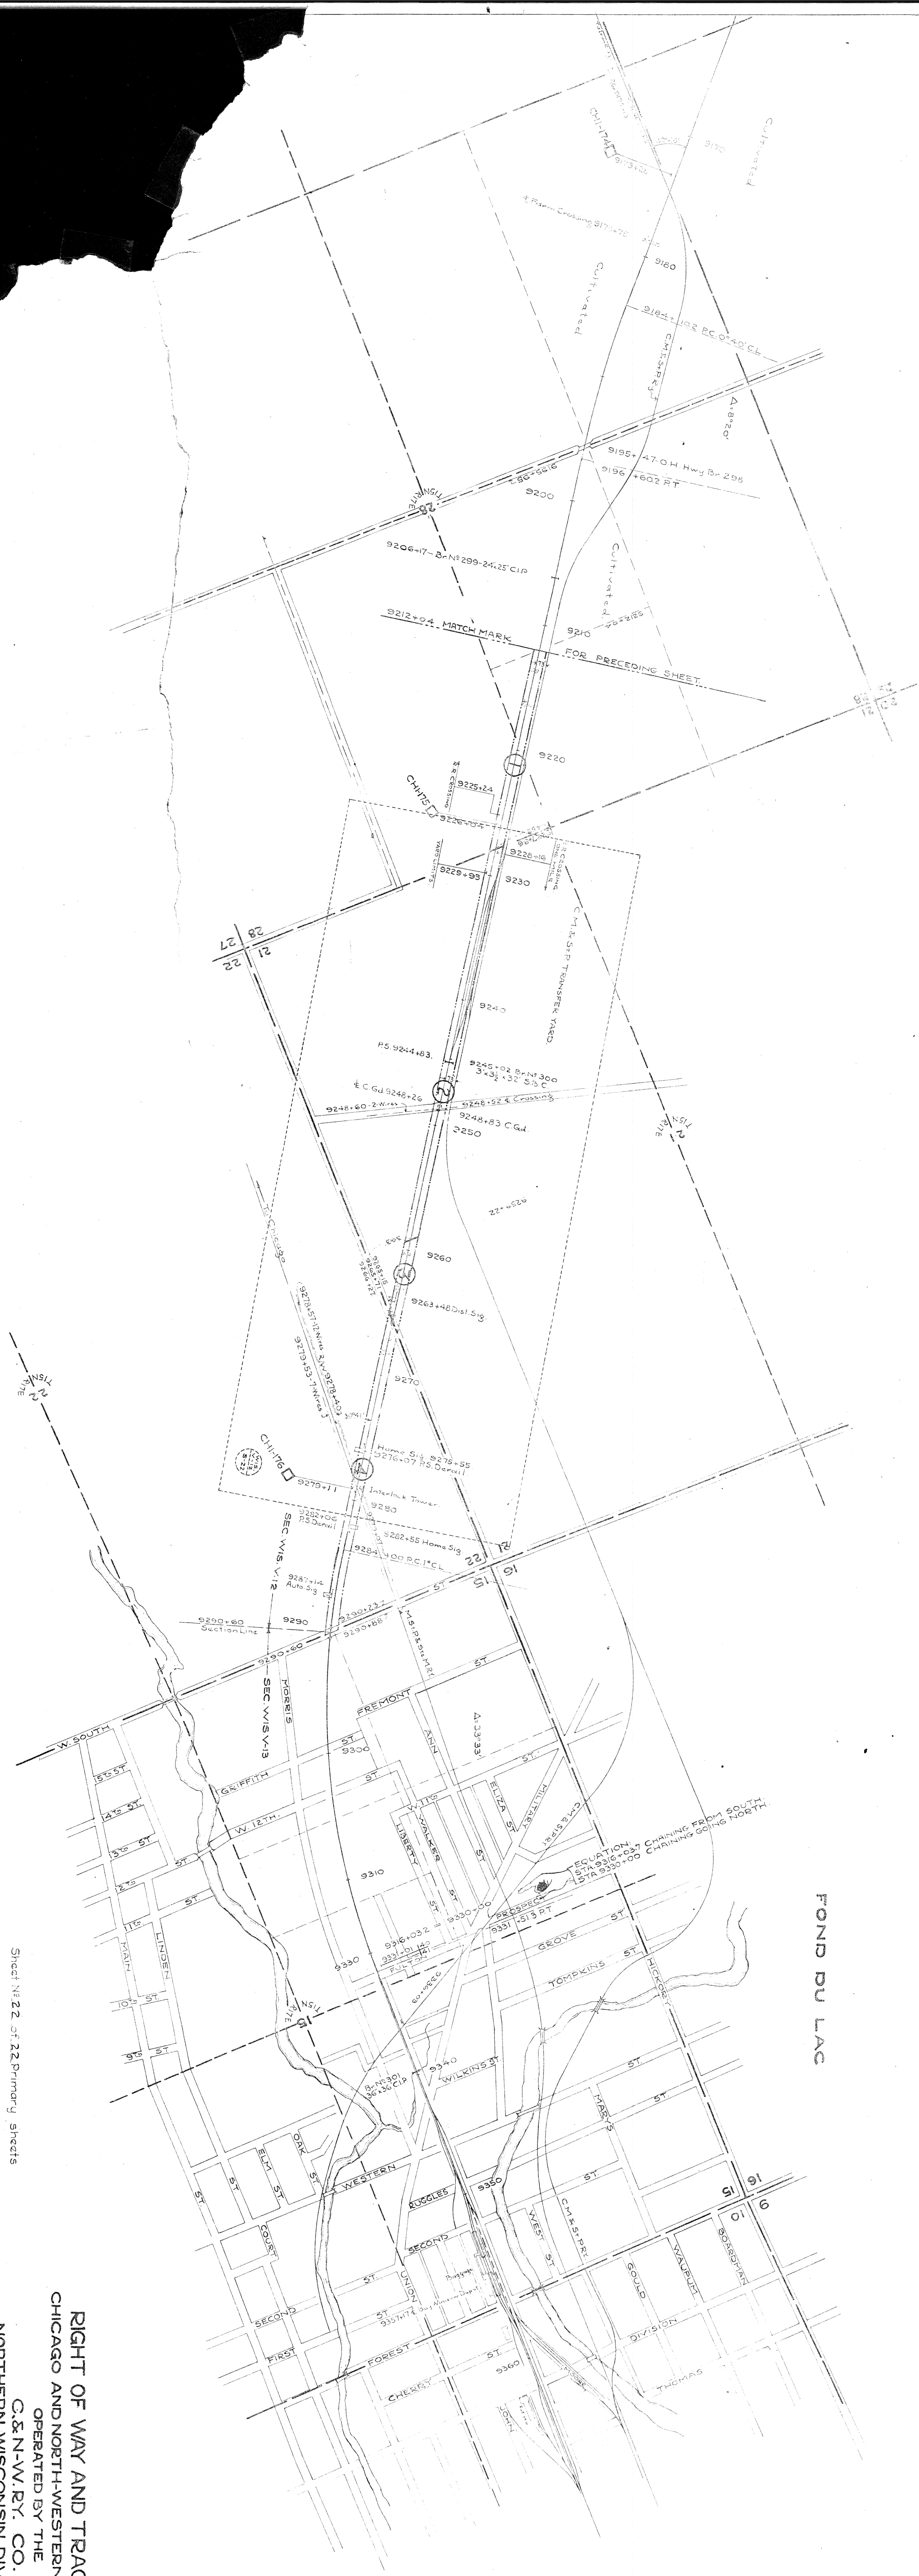

FOND DU LAC

Sheet No. 22 of 22 Primary sheets and 9 supplemental sheets of C.&N.W.R.Y. from survey station 9212+04 to survey station 9290+60

RIGHT OF WAY AND TRACK MAP
CHICAGO AND NORTH-WESTERN RAILWAY
OPERATED BY THE
C.&N.W.R.Y. CO.
NORTHERN WISCONSIN DIVISION
JANEVILLE, WIS. TO FOND DU LAC, WIS.
STA. 9212+04 TO STA. 9290+60
SCALE: 1" = 400'-FT.
OFFICE OF CHIEF ENGINEER
CHICAGO, ILL.

DATE	REVISION	BY	FOR
Dec 15, 1955	1	W. J. Dwyer	Original
May 27, 1956	2	W. J. Dwyer	As built
Apr 27, 1957	3	W. J. Dwyer	As built
Nov 17, 1957	4	W. J. Dwyer	As built
Nov 17, 1957	5	W. J. Dwyer	As built
