Lincoln County Section Summary

Section 8, T 32 N, R 5 E
Harding Township
Lincoln County, Wisconsin

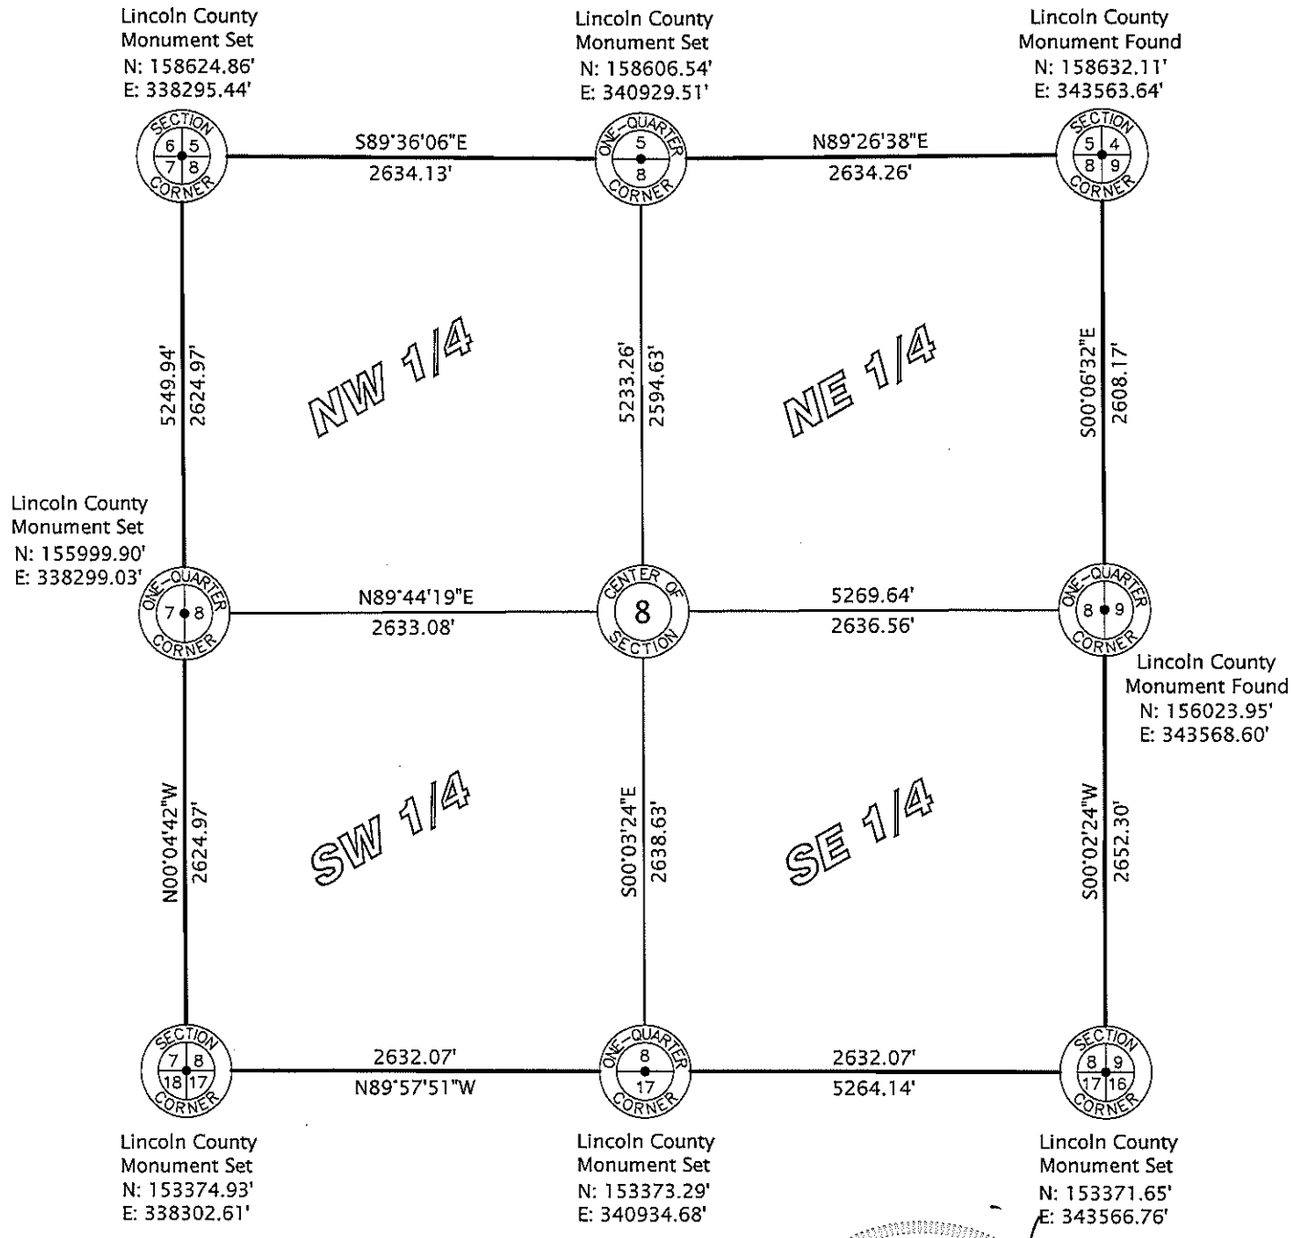

Lincoln County Grid

N
W E
S

RECEIVED BY LINCOLN COUNTY SURVEYOR THIS 5TH DAY OF October 2010

COUNTY SURVEYOR

WISCONSIN GREGORY S. MAINES S-2729 EAGLE RIVER, WI 10/1/2010 LAND SURVEYOR

I hereby certify that the information shown hereon is true and correct to the best of my knowledge and belief.

Scale 1" = 1000'

0' 500' 1000' 2000'

Favorite, Anderson & Maines Surveying, S.C.

5230 HWY 70 WEST - EAGLE RIVER, WI 54521

PHONE: (715) 479-2570 - FAX: (715) 479-7274

Sec. 8