Lincoln County Section Summary

Section 31, T 33 N, R 5 E
Harding Township
Lincoln County, Wisconsin

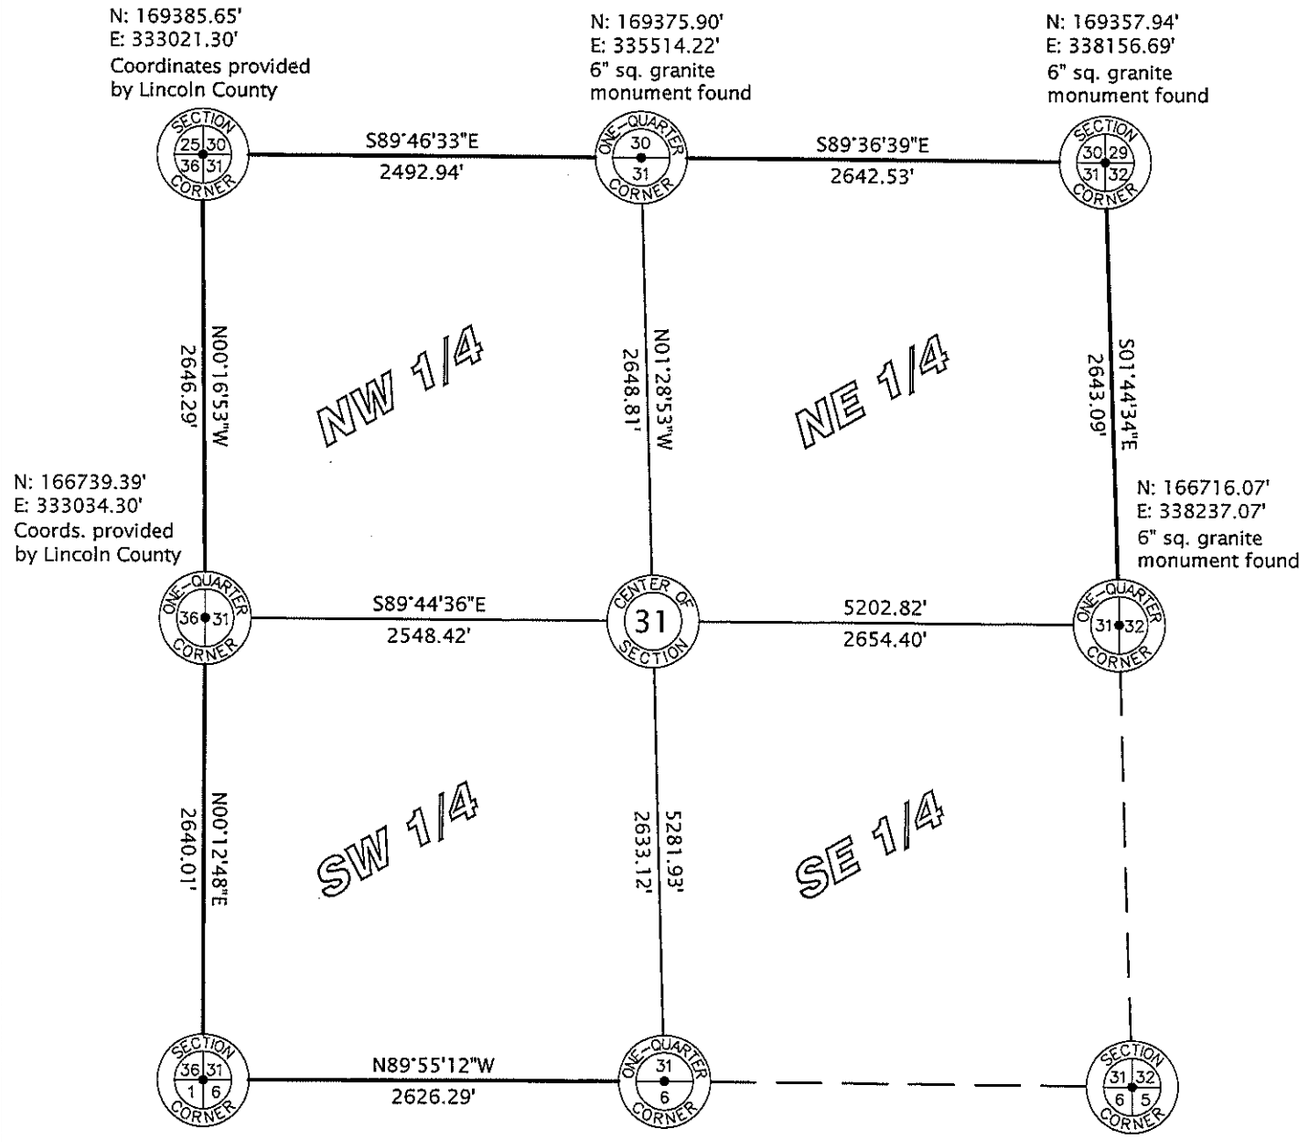

Lincoln County Grid

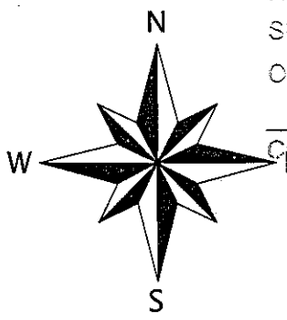

RECEIVED BY LINCOLN COUNTY SURVEYOR THIS 9TH DAY OF March 20 10

Tony Dahlen
COUNTY SURVEYOR

I hereby certify that the information shown hereon is true and correct to the best of my knowledge and belief.

Scale 1" = 1000'

0' 500' 1000' 2000'

Favorite, Anderson & Maines Surveying, S.C.

5230 HWY 70 WEST - EAGLE RIVER, WI 54521
PHONE: (715) 479-2570 - FAX: (715) 479-7274

Sec 31