Lincoln County Section Summary

Section 5, T 34 N, R 5 E
Tomahawk Township
Lincoln County, Wisconsin

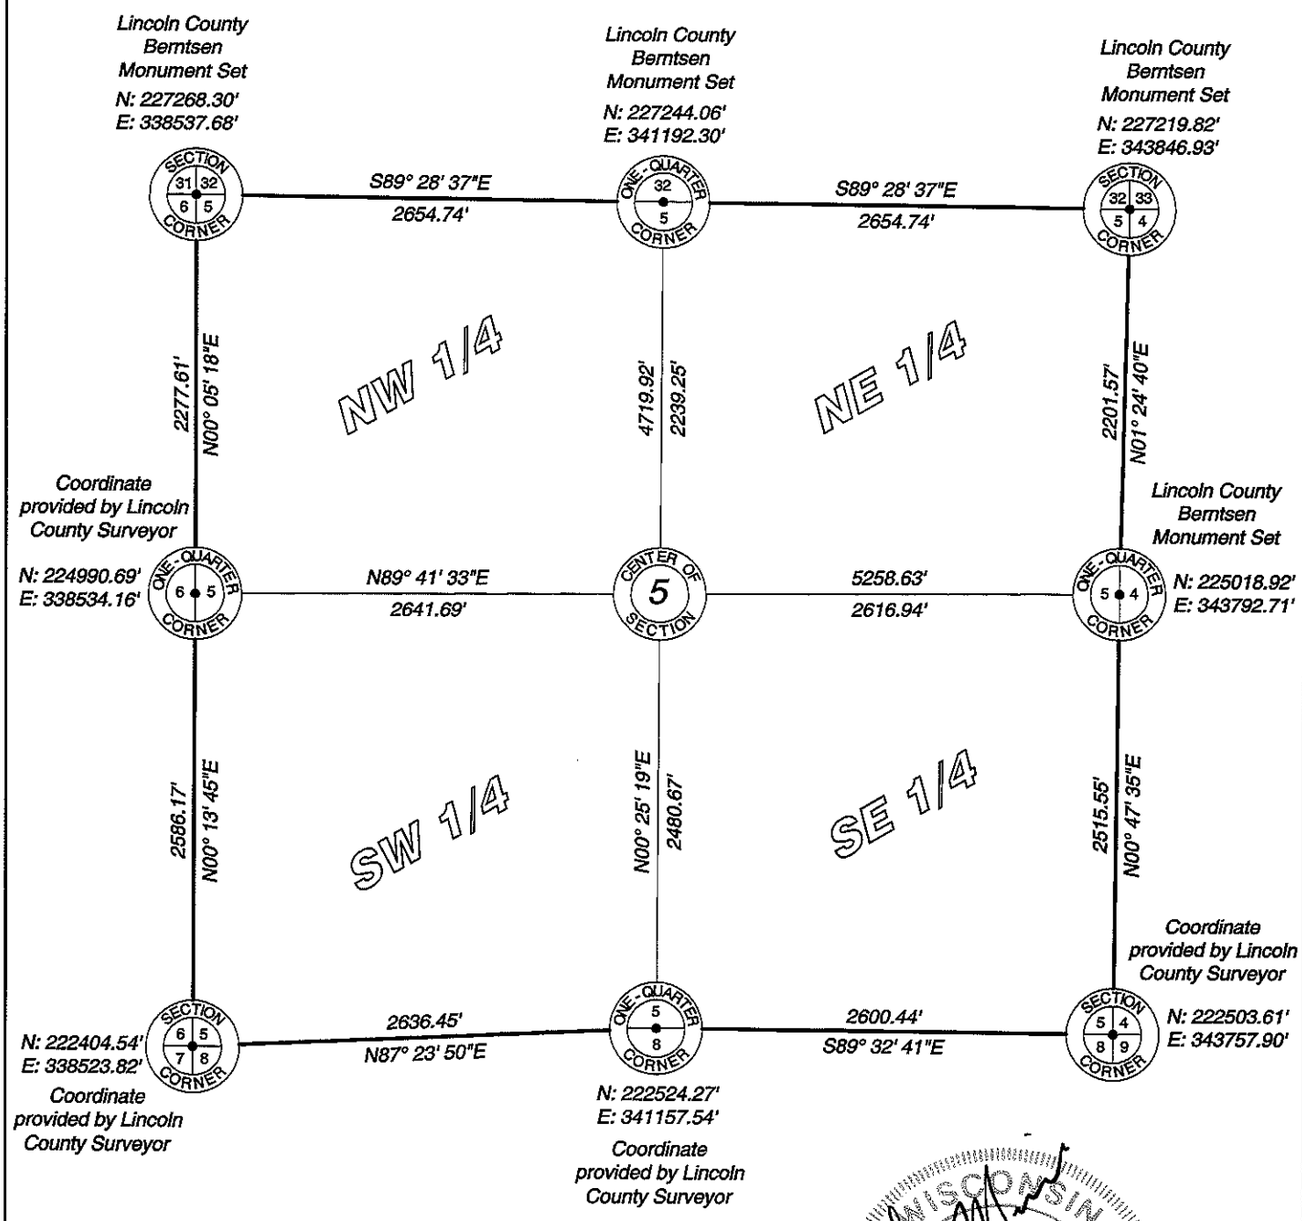

I hereby certify that the information shown hereon is true and correct to the best of my knowledge and belief.

MAINES & ASSOCIATES
Land Surveyors
5230 Highway 70 West
Eagle River, WI 54521
Phone 715.479.2570
Fax 715.479.7274
mainesandassociates.com

Sec 5