LINCOLN COUNTY SECTION SUMMARY

SECTION SUMMARY — 22 (SECTION) — 35N (TOWNSHIP) — 7E (RANGE)

KING (TOWN)

LEGEND

- FOUND GRANITE MONUMENT
- FOUND LINCOLN COUNTY MONUMENT
- SET LINCOLN COUNTY MONUMENT
- △ COORDINATES PER ONEIDA COUNTY
- ▲ P.K. NAIL, FOUND

N
W E
S

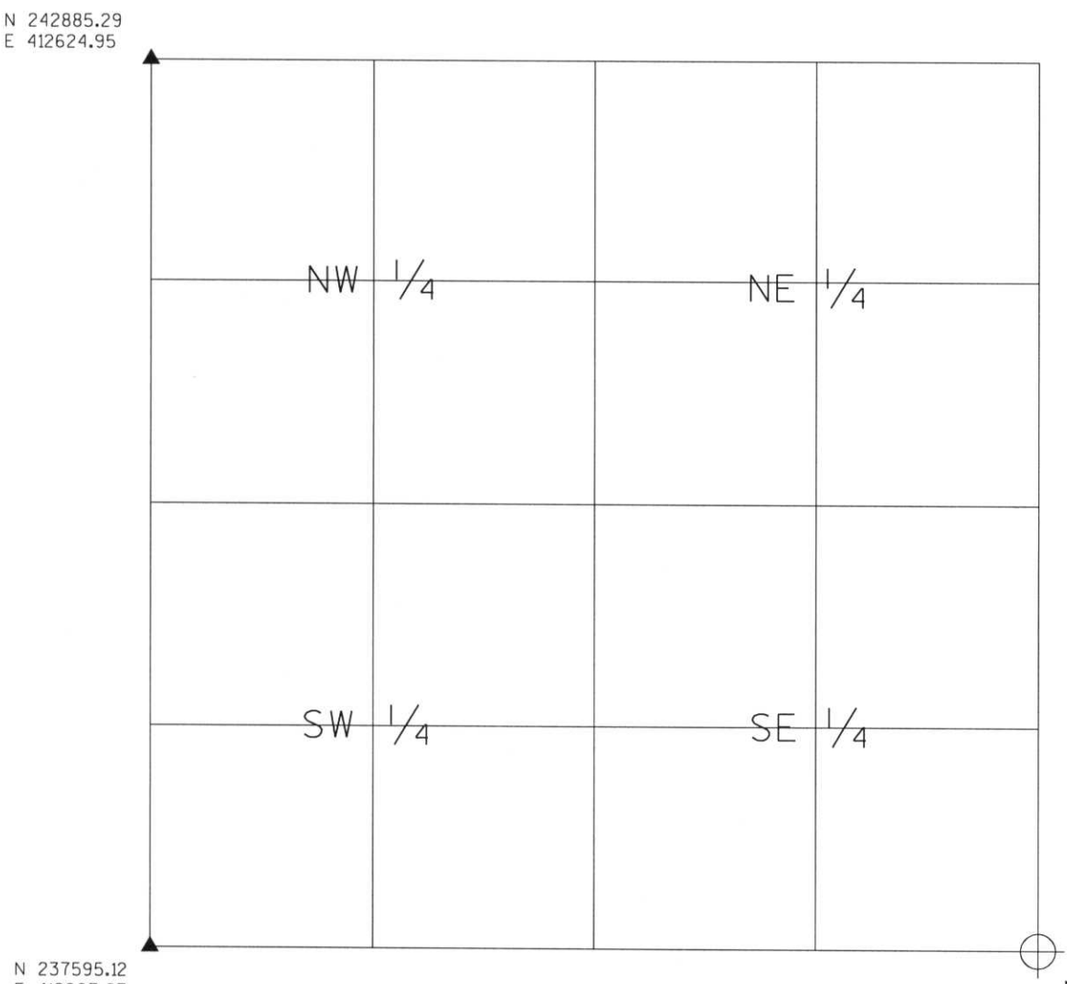

RECEIVED AT LINCOLN COUNTY COURTHOUSE THIS 19TH DAY OF December 20 03

Tony Dallman

LAND INFORMATION OFFICE

NOTES:
COORDINATES AND BEARINGS ARE REFERENCED TO THE LINCOLN COUNTY COORDINATE SYSTEM AS DEVELOPED BY THE WISCONSIN DEPARTMENT OF TRANSPORTATION AND WERE DETERMINED BY GPS OBSERVATIONS ON CONTROL POINTS AS SUPPLIED BY THE DOT.

WISCONSIN
JEFFREY L. DEMUTH
S-2656
RHINELANDER, WI
LAND SURVEYOR

CERTIFIED CORRECT:

Jeffrey L. DeMuth — 12/19/03

Signature — Date

Index No. M-Q : 13-17