MARATHON COUNTY U.S. PUBLIC LAND SURVEY MONUMENT LOCATION RECORD

SECTION 6
TOWNSHIP 30
RANGE 6
3
NO.

☒ LANDMARK ☐ BENCHMARK _____

FOUND ☒
SET ☐
RE-SET ☐
RE-TIED ☐

BERLIN
~~CITY, VILLAGE~~, TOWN

CORNER IDENTITY: P.K. NE COR

STATE PLANE COORDINATE: N: _____

ZONE: _____ E: _____

ELEVATION - (FEET): _____ DATUM: _____

THETA ANGLE: _____ WEATHER: _____

DATE OF SURVEY: July 1990 TEMPERATURE: _____ °F

SURVEY PARTY: Chet Gary

SECTION

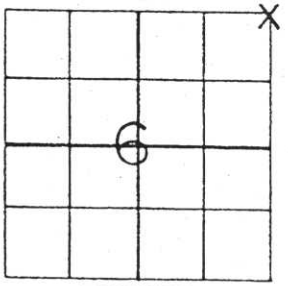

LOCATION
(Indicated By X)

N

BASIS FOR MONUMENT LOCATION:

(DESCRIBE METHOD OF SURVEY AND CORNER AUTHENTICATION)

Found existing P.K. set by Abendroth in traverse of Northline Sec. 6 thru 2. Fit my location, accepted as corner and referenced to County Coordinate System.

SEAL

WISCONSIN
CHESTER J. NOWACZYK
S-1143
WAUSAU, WIS.
LAND SURVEYOR

CERTIFIED CORRECT: Chester J. Nowaczyk
Registered Land Surveyor

DATE: July 1990

FIELD BOOK NO. _____ PAGE NO. _____

COMPANY Surveying Specialists Field Notes

TIE SKETCH:

SHOW MINIMUM OF FOUR (4) HORIZONTAL TIE DISTANCES TO FIXED WITNESS MONUMENTS. DESCRIBE ALL MONUMENTS FOUND OR SET. CORRECT ALL DISTANCES SHOWN TO STANDARD TEMPERATURE OF 68° F.

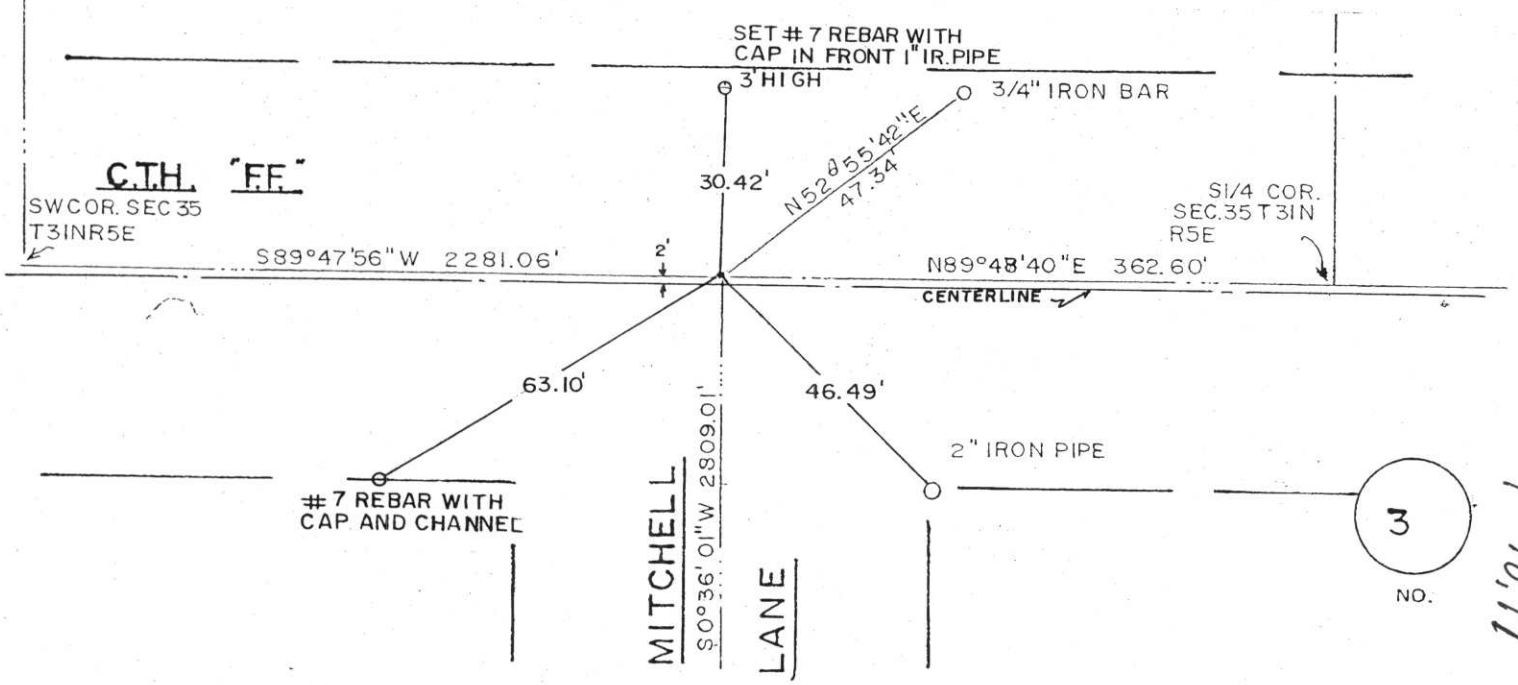

7-18-19