U.S. PUBLIC LAND SURVEY MONUMENT RECORD

Note: This form is intended and designed to fulfill all requirements of Wisconsin Administrative Code, Chapter A-E 5.02, U.S. Public Land Survey Monument Record (3) (a) (b) (c) (d) (e) (f) (g) (h) (i). An additional sheet may be added if necessary to conform with said requirements.

(a) Corner location: Township 32 North

Range 8 East

Town SCHLEY

County LINCOLN

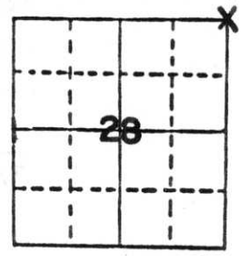

Section

b) (f) (g) (h) Description of monument found at this corner and if it was accepted, state all evidence (material, testimonial, occupational, plats, records, other monuments) used as a basis for accepting. If not accepted or if nothing was found, state evidence used as basis for establishing location. If reestablished through lost corner proportionate methods, indicate all monuments, distances and directions used to establish.

Found existing PK nail in the centerline of C.T.H. "C" and Mosser Road. Traversed to existing corners of record in all four directions. Also located existing forty fences. All forty fences fit split of ½ mile distances. Set Railroad Spike at location of existing PK nail and accepted as corner. Did not dig because of pavement.

c) (d) (e) Plan view of corner with ties to at least 4 witness monuments. If in disagreement with previously established corner, show the distances between the two corners and also indicate the ties to the disputed corner.

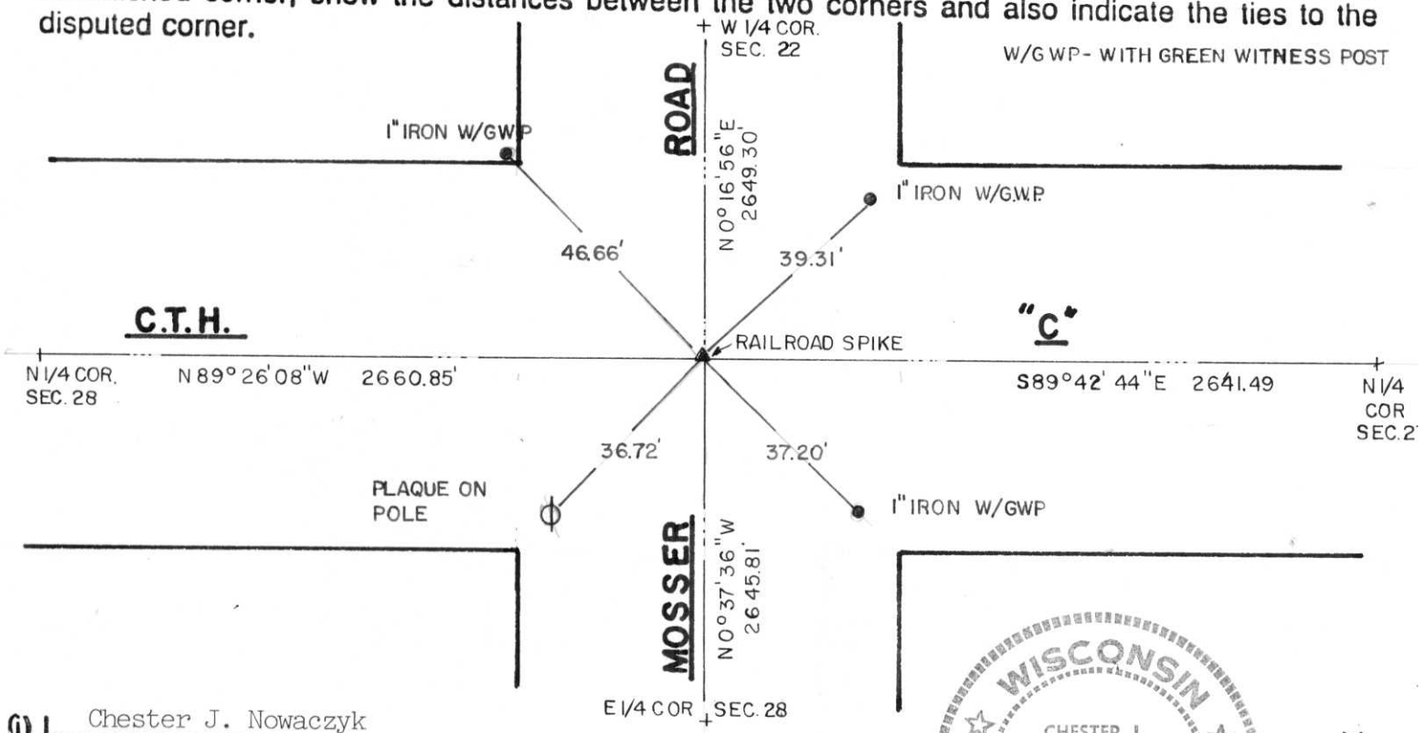

(i) I, Chester J. Nowaczyk (type or print name) certify that the corner location on this record was determined by me or under my direction and control and that this U.S. Public Land Survey Monument Record is correct and complete to the best of my knowledge and belief.

Chester J. Nowaczyk 11-26-87

Signature Date

WISCONSIN CHESTER J. NOWACZYK S-1443 WAUSAU, WIS. LAND SURVEYOR

AFFIX SEAL HERE

Index No. Q-13