U.S. PUBLIC LAND SURVEY MONUMENT RECORD

Note: This form is intended and designed to fulfill all requirements of Wisconsin Administrative Code, Chapter A-E 5.02, U.S. Public Land Survey Monument Record (3) (a) (b) (c) (d) (e) (f) (g) (h) (i). An additional sheet may be added if necessary to conform with said requirements.

(a) Corner location: Township 33 North

Range 7 East/~~West~~

Town/~~City/Village~~ BIRCH

County LINCOLN

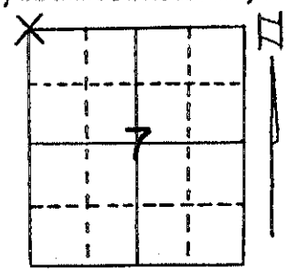

Section 7

(b) (f) (g) (h) Description of monument found at this corner and if it was accepted, state all evidence (material, testimonial, occupational, plats, records, other monuments) used as a basis for accepting. If not accepted or if nothing was found, state evidence used as basis for establishing location. If reestablished through lost corner proportionate methods, indicate all monuments, distances and directions used to establish.

Could find no record of this corner per research at Lincoln County Surveyor's office except for notes by Francis Fox from re-survey of Town of Rock Falls in 1941-1942. Commenced measurement at Northeast corner of Section 7-33-7 and traversed West. We recovered a 6"x6" red granite stone with chisel "X" 1 foot West of old fence corner, said fence corner being a 5' high iron rail. Stone protrudes about 16 inches above ground and has a 1½" iron pipe placed along South face of monument. Accepted stone as corner and tied out to trees as surrounding ground is too swampy for iron pipes to be set firmly.

(c) (d) (e) Plan view of corner with ties to at least 4 witness monuments. If in disagreement with previously established corner, show the distances between the two corners and also indicate the ties to the disputed corner.

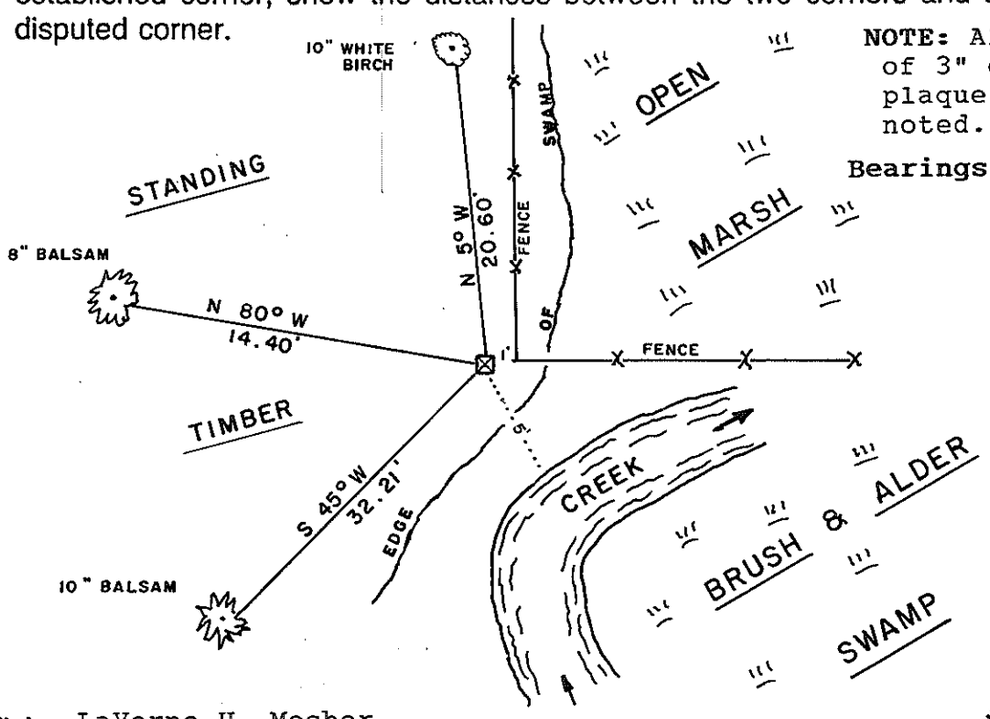

NOTE: All ties are to head of 3" cut nail in metal plaque on blazed tree noted.

Bearings approximate.

RECEIVED AUG 26 1991

(i) I, LaVerne H. Mosher (type or print name) certify that the corner location on this record was determined by me or under my direction and control and that this U.S. Public Land Survey Monument Record is correct and complete to the best of my knowledge and belief.

LaVerne H. Mosher — AUGUST 2, 1991

Signature — Date

WISCONSIN LaVERNE H. MOSHER S-1188 SCHOFIELD, WIS. LAND SURVEYOR

Index No. E-1