U.S. PUBLIC LAND SURVEY MONUMENT RECORD

Note: This form is intended and designed to fulfill all requirements of Wisconsin Administrative Code, Chapter A-E 5.02, U.S. Public Land Survey Monument Record (3) (a) (b) (c) (d) (e) (f) (g) (h) (I). An additional sheet may be added if necessary to conform with said requirements.

(a) Corner location: Township 33 North

Range 7 East

Town/City/Village BIRCH

County Lincoln

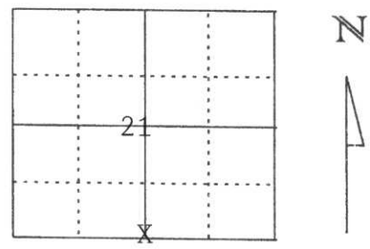

Section 21

(b) (f) (g) (h) Description of monument found at this corner and if it was accepted, state all evidence (material, testimonial, occupational, plats, records, other monuments) used as a basis for accepting. If not acceptted or if nothing was found, state evidence used as basis for establishing location. If reestablished through lost corner proportionate methods, indicate all monuments, distances and directions used to establish.

Dug at a point 15½ feet North of the South end of the culvert on the East ditch line, on the West side of the culvert. Long time local resident said he had seen it there. At a point 4' below the surface of Copper Lake Road, at the East line of Waldburger Road, we located a 7"x7" red granite stone. We accepted this location. We then placed a 7/8"x30" rebar over the center of the stone to aid in location. We then tied this point to 7/8" rebar as witness monuments.

RECEIVED AT LINCOLN COUNTY COURTHOUSE THIS 1st DAY OF Sept 19 98.
Pat Priebe
TAX DESCRIPTION OFFICE

(c) (d) (e) Plan view of corner with ties to at least 4 witness monuments. If in disagreement with previously established corner, show the distances between the two corners and also indicate the ties to the disputed corner.

NOTE: All Witness ties are 7/8" rebar with Lincoln County Caps.

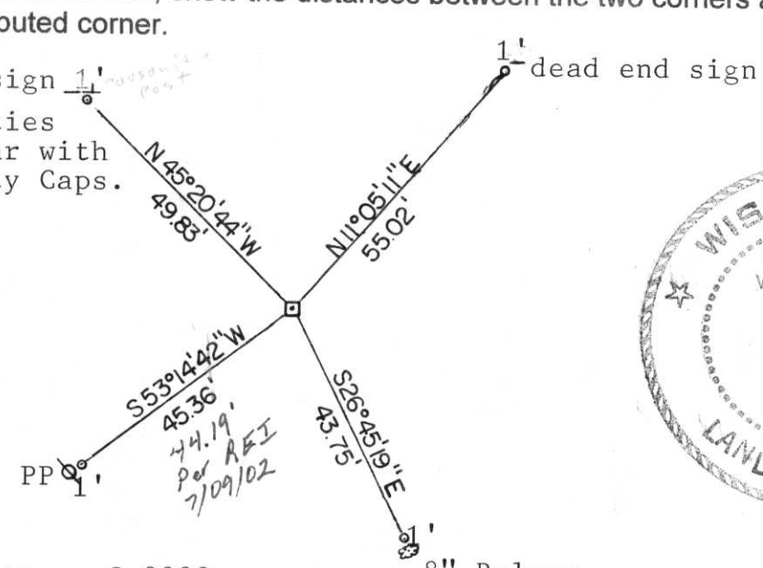

WISCONSIN
WILLIAM W. NUTTER
S-2299
MERRILL, WIS.
LAND SURVEYOR

(I) I, William W. Nutter S-2299 (type or print name) certify that the corner location on this record was determined by me or under my direction and control and that this U.S. Public Land Survey Monument Record is correct and complete to the best of my knowledge and belief.

William W. Nutter — 8-18-98

Signature — Date

Index No. Q-11

(revised 2/97)