LINCOLN COUNTY U.S. PUBLIC LAND SURVEY MONUMENT LOCATION RECORD

SECTION 5
TOWNSHIP 34 N
RANGE 4 E

E-9
NO.

☒ LANDMARK ☐ BENCHMARK _____

FOUND ☐
SET ☐
RESET ☒
RE-TIED ☒

CORNER IDENTITY: BERNTSEN SNM1 STEEL NAIL MARKER

TOMAHAWK
CITY, VILLAGE, TOWN

LINCOLN COUNTY COORDINATE: N: 221979.477
E: 312388.748

SECTION

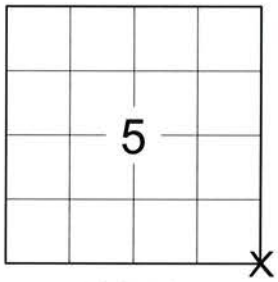

LOCATION
(Indicated By X)

ELEVATION-(FEET): _____ DATUM: 83 (2011)

WEATHER: P. CLOUDY

DATE OF SURVEY: 07/25/2019 TEMPERATURE: 80 °F

SURVEY PARTY: KEITH WALKOWSKI AND AUSTIN PELOT

BASIS FOR MONUMENT LOCATION:

(DESCRIBE METHOD OF SURVEY AND CORNER AUTHENTICATION)

SEARCHED FOR THE SOUTHEAST CORNER OF SECTION 5 AND FOUND A SMP NAIL AND 3 TIES FROM THE 2012 TIE SHEET BY MAINES. RESET THE DISTURBED REBAR AND SET A BERNTSEN SNM1 STEEL NAIL MARKER AT THE CORNER UPON COMPLETION OF THE STH 86 RESURFACING PROJECT TO PERPETUATE THE CORNER LOCATION AS SHOWN BELOW.

WISCONSIN
KEITH J. WALKOWSKI S-2717 MOSINEE, WI
LAND SURVEYOR

CERTIFIED CORRECT: Keith J Walkowski

KEITH J. WALKOWSKI S-2717
Professional Land Surveyor

DATE: OCTOBER 15TH, 2019

FIELD BOOK NO. NA PAGE NO. NA

COMPANY RIVERSIDE LAND SURVEYING LLC

TIE SKETCH:

- SET BERNTSEN SNM1 STEEL NAIL MARKER
- FOUND ALUMINUM CAPPED 7/8" REBAR
- SET VINYL "T" POST

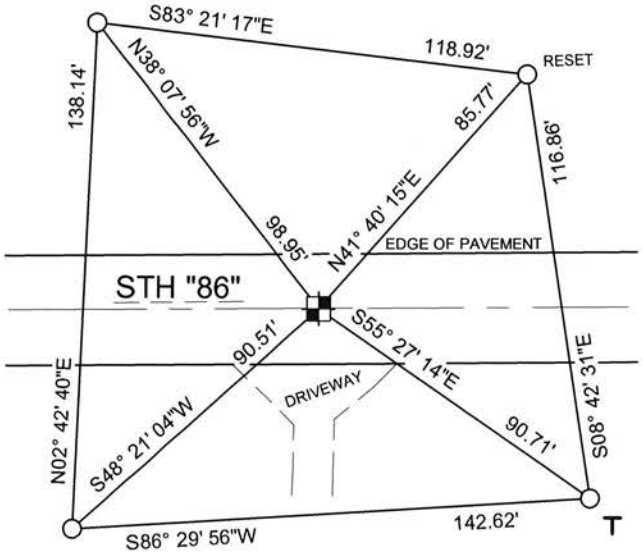

RECEIVED BY LINCOLN COUNTY SURVEYOR THIS 12TH DAY OF November 2019
Jerry Dahl
COUNTY SURVEYOR

NOTE: CORNER LIES ON CENTERLINE OF STH 86

BEARINGS ARE BASED ON THE LINCOLN COUNTY COORDINATE SYSTEM NAD 83 (2011) AND REFERENCED AS SHOWN

THIS DRAWING IS NOT TO SCALE

E-9
NO.

U.S. PUBLIC LAND SURVEY MONUMENT RECORD

NOTE: THIS FORM IS INTENDED AND DESIGNED TO FULFILL ALL REQUIREMENTS OF WISCONSIN ADMINISTRATIVE CODE CHAPTER A-E 7.08 U.S. PUBLIC LAND SURVEY MONUMENT RECORD (3) (a)(b)(c)(d)(e)(f)(g)(h)(i). AN ADDITIONAL SHEET MAY BE ADDED IF NECESSARY TO CONFIRM WITH SAID REQUIREMENTS.

(a) CORNER LOCATION:

SOUTHEAST CORNER OF SECTION 5
TOWNSHIP 34 NORTH
RANGE 4 EAST
TOWN OF TOMAHAWK
COUNTY OF LINCOLN

LINCOLN COUNTY COORDINATES:

N: 221979.48
E: 312388.65

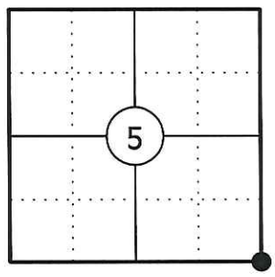

(b) HISTORY OF ORIGINAL CORNER:

ORIGINAL SURVEYOR: EDWARD D. PALMER
DATE OF SURVEY: APRIL 1865

ORIGINAL BEARING TREES: 5" CEDAR - N20°W, 10 LKS
3" CEDAR - N30°E, 12 LKS
5" CEDAR - S60°E, 1 LKS
5" CEDAR - S27°W, 11 LKS

(f)(g)(h) DESCRIPTION OF MONUMENT FOUND AT THIS CORNER AND IF IT WAS ACCEPTED STATE ALL EVIDENCE (MATERIAL, TESTIMONIAL, OCCUPATIONAL, PLATS, RECORDS, OTHER MONUMENTS) USED AS A BASIS FOR ESTABLISHING LOCATION. IF REESTABLISHING THROUGH LOST CORNER PROPORTIONATE METHODS, INDICATE ALL MONUMENTS, DISTANCES, AND DIRECTIONS USED TO ESTABLISH. INDICATE TYPE OF MONUMENT AND SIGN POST FOUND OR SET.

1865: EDWARD D. PALMER SET THE ORIGINAL SECTION CORNER POST.

03/06/1987: WILLIAM STUTH PREPARED A MAP OF A 1971 SURVEY PERFORMED BY OWENS-ILLINOIS AND SHOWS THE CORNER POSITION AT THE INTERSECTION OF HIGHWAY 86 AND A ROAD RUNNING SOUTH.

05/29/2012: I FOUND NO EVIDENCE OF THE ORIGINAL CORNER. THE O.I. MAP AND PLAT BOOKS FROM THE EARLY 1900'S SHOW THIS CORNER AT THE INTERSECTION OF TWO ROADS. THE PROPERTY OWNER TO THE WEST HAS LIVED ON THE PROPERTY ALL HIS LIFE AND ALWAYS UNDERSTOOD THE CORNER TO BE IN THE INTERSECTION. I WENT SOUTH TO THE 1/16 CORNER AND FOUND A SCRIBED WOOD POST ON THE WEST SIDE OF THE ROAD AND A BENT OVER 1 1/4" DIA. IRON PIPE LAYING FLAT ON THE EAST SIDE OF THE ROAD. I POSITIONED THE SECTION CORNER AT THE CENTERLINE INTERSECTION OF HIGHWAY 86 AND THE WOODS ROAD RUNNING SOUTH. I SET A BERNTSEN STEEL SPIKE TO MONUMENT THE CORNER AND SET FOUR REFERENCE MONUMENTS TO WITNESS THE CORNER.

(c)(d)(e) PLAN VIEW OF CORNER WITH TIES TO AT LEAST FOUR WITNESSES. IF IN DISAGREEMENT WITH PREVIOUSLY ESTABLISHED CORNER, SHOW THE DISTANCES BETWEEN THE TWO CORNERS AND ALSO INDICATE THE TIE TO THE DISPUTED CORNER.

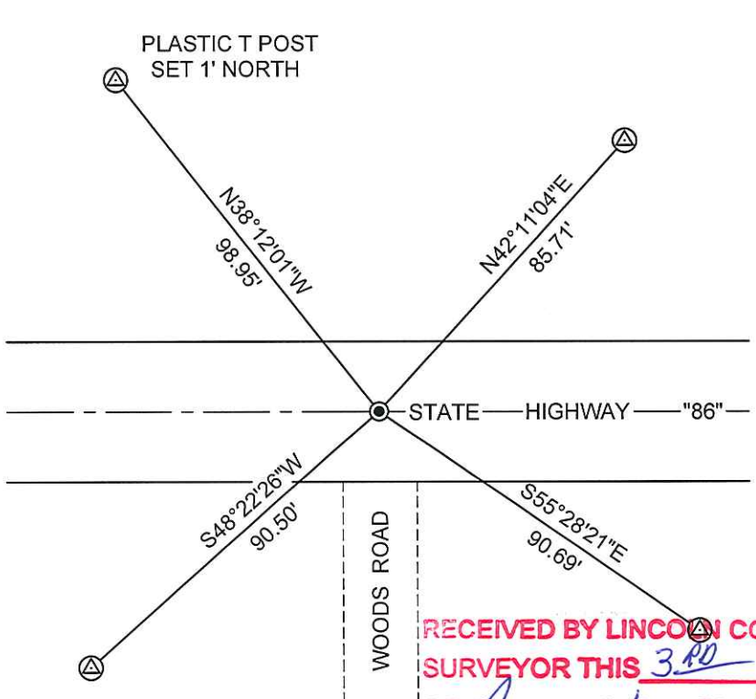

△ 3/4" X 30" IRON REBAR WITH LINCOLN CO. ALUM. CAP SET

◉ BERNTSEN STEEL SPIKE SET

SKETCH IS NOT TO SCALE

DISTANCES TO BT'S ARE TO NAIL IN SIDE

RECEIVED BY LINCOLN COUNTY SURVEYOR THIS 3rd DAY OF August 2012

Tom Dall
COUNTY SURVEYOR

CERTIFICATION

I GREGORY S. MAINES, REGISTERED LAND SURVEYOR NO. 2729, HEREBY CERTIFY THAT THE CORNER LOCATION ON THIS RECORD WAS REFERENCED BY ME OR UNDER MY DIRECTION AND CONTROL AND THAT THIS U.S. PUBLIC LAND SURVEY MONUMENT RECORD IS COMPLETE TO THE BEST OF MY KNOWLEDGE AND BELIEF.

Gregory S. Maines 5/29/12
SIGNATURE

WISCONSIN
GREGORY S. MAINES
S-2729
EAGLE RIVER, WI
LAND SURVEYOR

INDEX NO. E-9

SOUTHEAST CORNER - SECTION 5, T 34 N, R 4 E

OVERVIEW

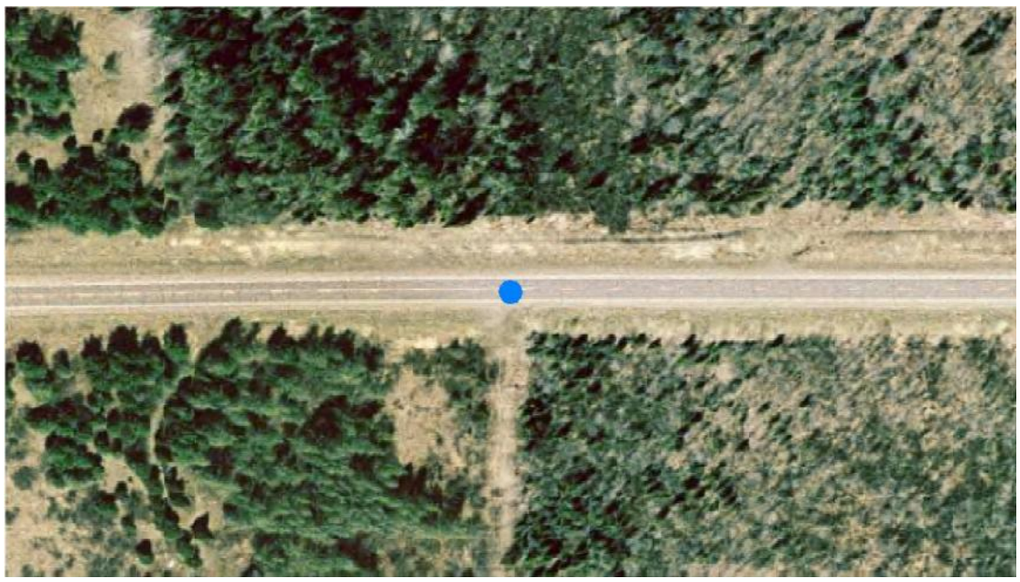

MONUMENT SET

FACING NORTH

SOUTHEAST CORNER - SECTION 5, T 34 N, R 4 E

FACING EAST

FACING SOUTH

FACING WEST