TAYLOR COUNTY
U.S. PUBLIC LAND SURVEY MONUMENT RECORD

Sec 19-31-4
NW

Original Corner Information

Original corner monument: post
Set by: William E. Daugherty
Year: 1861

Bearing Trees

Species:	birch	birch	birch	sugar
Diameter:	12"	12"	9"	8"
Bearings:	N 45° E	S 33° E	S 30° W	N 31° W
Distance:	3 links	43 links	15 links	56 links

RECEIVED AT LINCOLN COUNTY COURTHOUSE THIS 10th DAY OF Feb. 2000
Amy Dallman
LAND INFORMATION OFFICE

Original Evidence Found – Subsequent Corner Restorations

(Include year of search, name of surveyor, evidence found and monument set.)

May 3–5, 1920, J.A. Franzen, "iron post" no mention whether found or set.

June 11, 1927, unsigned survey for road along North/South ¼ line of Section 13–31–3E. No mention of monument found or set.

Basis For Monument Location

After no evidence of the original corner nor any perpetuation thereof could be found this corner was set at the intersection of fences to North, South, East and West. I believe said fence intersection is the best available evidence of this corners location.

Tie Sketch

(Show type of monument set, at least four ties, fence lines, roads and topography.)

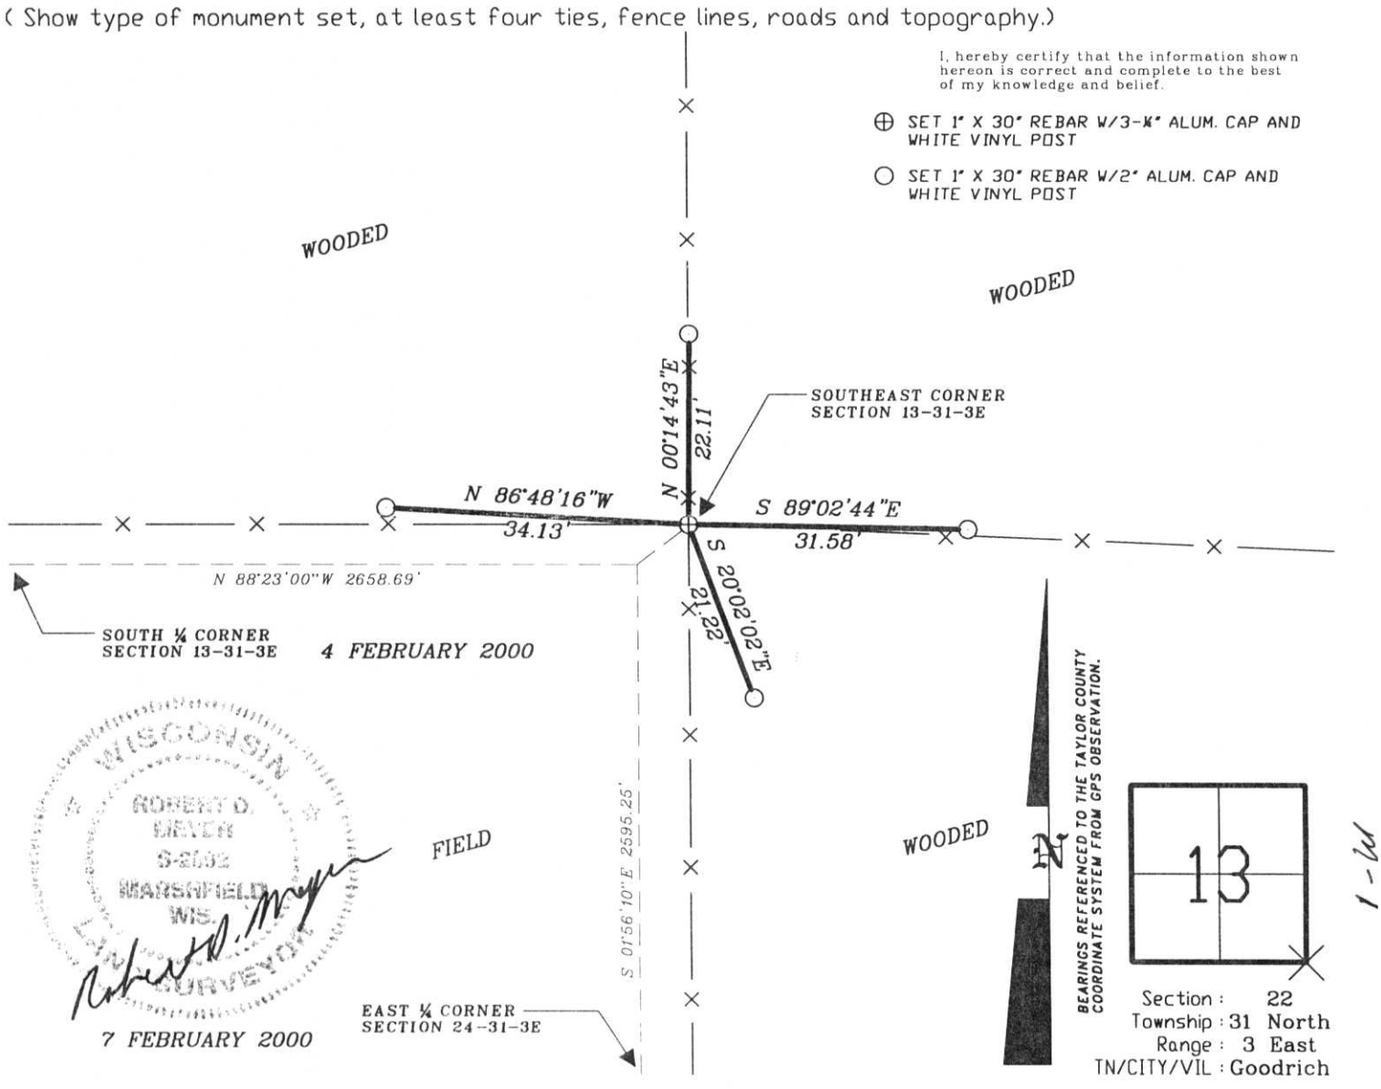

1-pd