U.S. PUBLIC LAND SURVEY MONUMENT RECORD

Note: This form is intended and designed to fulfill all requirements of Wisconsin Administrative Code, Chapter A-E 5.02, U.S. Public Land Survey Monument Record (3) (a) (b) (c) (d) (e) (f) (g) (h) (i). An additional sheet may be added if necessary to conform with said requirements.

(a) Corner location: Township 31 North

Range 4 East

Town/~~City/Village~~ CORNING

County LINCOLN

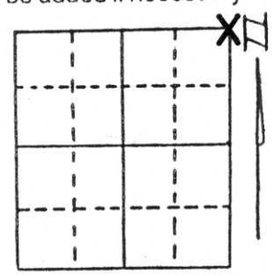

Section 23

(b) (f) (g) (h) Description of monument found at this corner and if it was accepted, state all evidence (material, testimonial, occupational, plats, records, other monuments) used as a basis for accepting. If not accepted or if nothing was found, state evidence used as basis for establishing location. If reestablished through lost corner proportionate methods, indicate all monuments, distances and directions used to establish.

Original corner - Wood Post set by W.E. Daugherty, 1851?. No remonumentation notes available.
Excavated for corner in April, 1994 and found no evidence of corner. Traversed all of Sections 23, 25 and 26, and most of Section 24. Corner point establishec from road centerline and old fence line running to South; said point in harmony with occupational lines in area. Set a Standard Lincoln County Berntsen Monumer at corner. Filed Section breakdown sheet of Section 23 with County Surveyor's Office.

RECEIVED AT LINCOLN COUNTY COURTHOUSE THIS 25 DAY OF May 1995.
Pat Quilter
TAX DESCRIPTION OFFICE

(c) (d) (e) Plan view of corner with ties to at least 4 witness monuments. If in disagreement with previously established corner, show the distances between the two corners and also indicate the ties to the disputed corner.

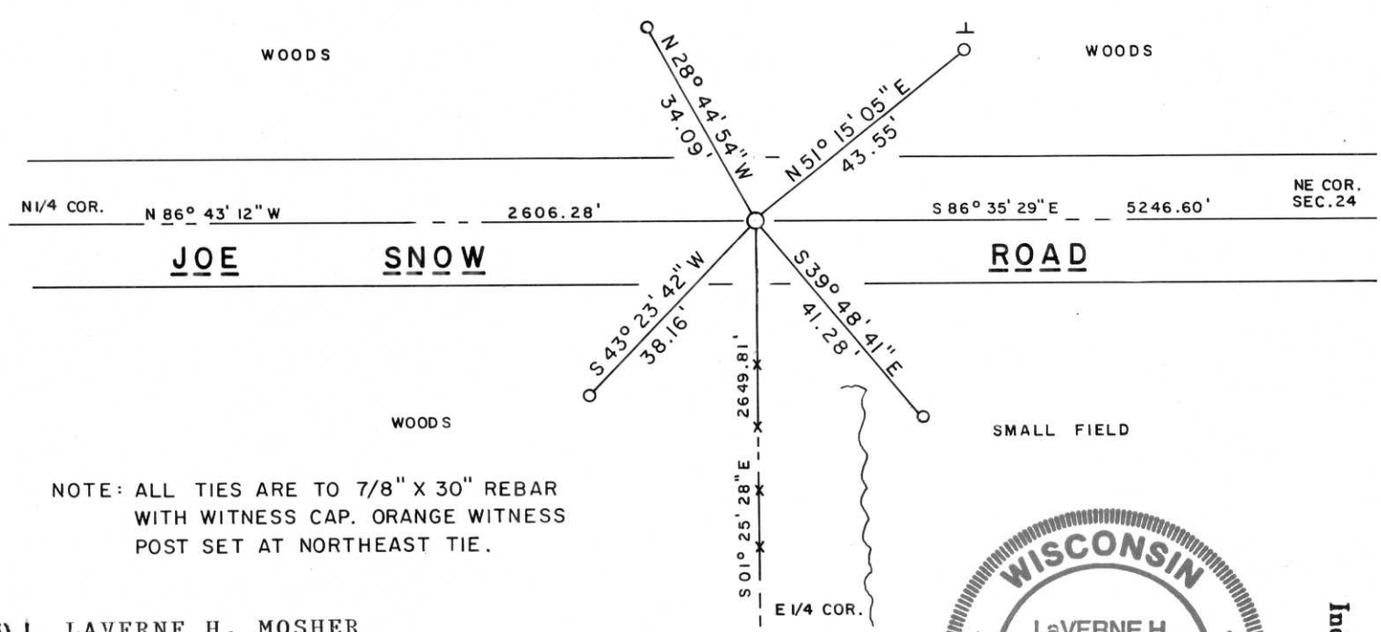

NOTE: ALL TIES ARE TO 7/8" X 30" REBAR WITH WITNESS CAP. ORANGE WITNESS POST SET AT NORTHEAST TIE.

(i) I, LAVERNE H. MOSHER (type or print name) certify that the corner location on this record was determined by me or under my direction and control and that this U.S. Public Land Survey Monument Record is correct and complete to the best of my knowledge and belief.

LaVerne H. Mosher — MAY 24, 1995

Signature — Date

WISCONSIN LaVERNE H. MOSHER S-1188 SCHOFIELD, WI LAND SURVEYOR

Index No. M-21