U.S. PUBLIC LAND SURVEY MONUMENT RECORD

Note: This form is intended and designed to fulfill all requirements of Wisconsin Administrative Code, Chapter A-E 5.02, U.S. Public Land Survey Monument Record (3) (a) (b) (c) (d) (e) (f) (g) (h) (i). An additional sheet may be added if necessary to conform with said requirements.

(a) Corner location: Township 31 North

Range 5 East

Town/~~City/Village~~ CORNING

County LINCOLN

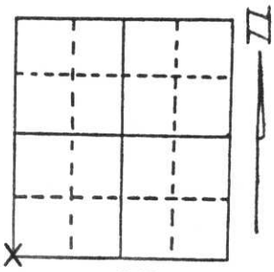

Section 27

(b) (f) (g) (h) Description of monument found at this corner and if it was accepted, state all evidence (material, testimonial, occupational, plats, records, other monuments) used as a basis for accepting. If not accepted or if nothing was found, state evidence used as basis for establishing location. If reestablished through lost corner proportionate methods, indicate all monuments, distances and directions used to establish.

Dug a 7'X10'hole with a backhoe at the intersection of the centerlines of Midway &Highland roads. Found a 6"X6"X30" limestone monument 3' South of the centerline of Highland Avenue and on the centerline of Midway Road. Top 12" of stone was broken off and remaining portion was 36" below road surface. A Berntsen Monument was then set over the remaining portion of the stone. the top of the Berntsen monument is 10" below the road surface.

As no evidence of the original corner nor its accessories could be found this position was accepted as the best available evidence of this corners location.

Witnesses: Clifford Hass (backhoe operator)
David Storm

(c) (d) (e) Plan view of corner with ties to at least 4 witness monuments. If in disagreement with previously established corner, show the distances between the two corners and also indicate the ties to the disputed corner.

NOTE: All ties are to 7/8" x 24" rebar set flush.

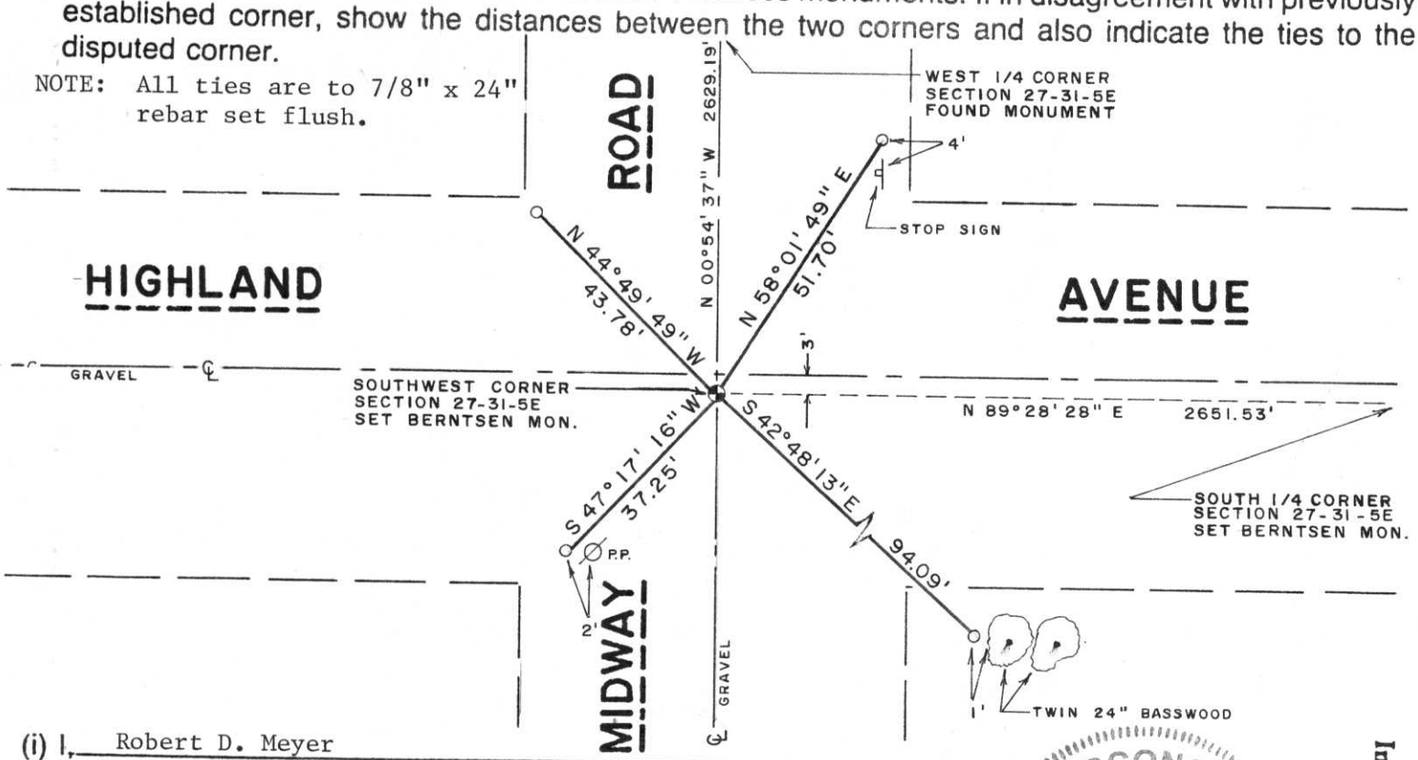

(i) I, Robert D. Meyer (type or print name) certify that the corner location on this record was determined by me or under my direction and control and that this U.S. Public Land Survey Monument Record is correct and complete to the best of my knowledge and belief.

Robert D. Meyer 6/21/94

Signature Date

WISCONSIN ROBERT D. MEYER S-2092 MARSHFIELD WIS. LAND SURVEYOR

Index No. 11-13