U.S. PUBLIC LAND SURVEY MONUMENT RECORD

Note: This form is intended and designed to fulfill all requirements of Wisconsin Administrative Code, Chapter A-E 5.02, U.S. Public Land Survey Monument Record (3) (a) (b) (c) (d) (e) (f) (g) (h) (i). An additional sheet may be added if necessary to conform with said requirements.

(a) Corner location: Township 31 North

Range 5 East

Town _____

County LINCOLN

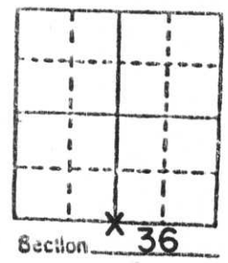

Section 36

b) (f) (g) (h) Description of monument found at this corner and if it was accepted, state all evidence (material, testimonial, occupational, plats, records, other monuments) used as a basis for accepting. If not accepted or if nothing was found, state evidence used as basis for establishing location. If reestablished through lost corner proportionate methods, indicate all monuments, distances and directions used to establish.

Corner area was excavated and no evidence of the corner was found. An extensive traverse was run along the county line locating all existing Marathon and Lincoln County corners as well as fence lines. This field work was compared with original and re-monumentation notes and the corner location was determined.

Set 1 3/16" x 30" iron bar.

c) (d) (e) Plan view of corner with ties to at least 4 witness monuments. If in disagreement with previously established corner, show the distances between the two corners and also indicate the ties to the disputed corner.

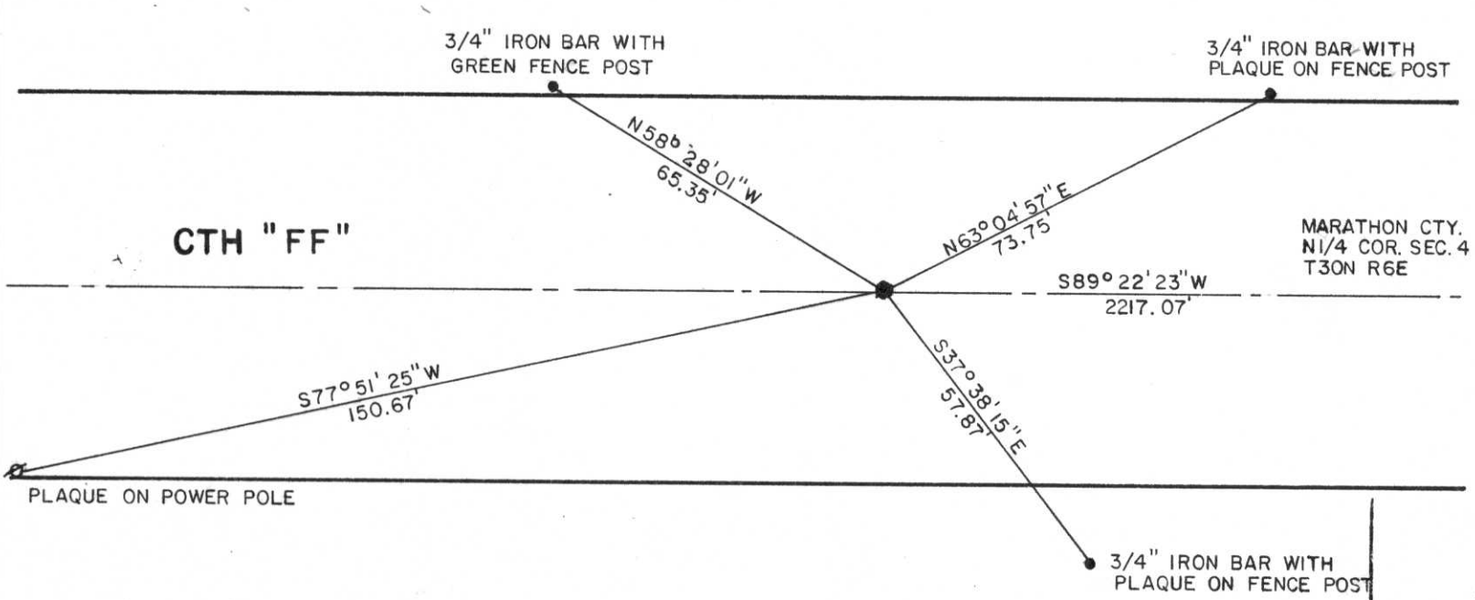

(i) I, Chester J. Nowaczyk RLS NO.1143 (type or print name) certify that the corner location on this record was determined by me or under my direction and control and that this U.S. Public Land Survey Monument Record is correct and complete to the best of my knowledge and belief.

Chester J. Nowaczyk — Signature

11-2-90 — Date

WISCONSIN CHESTER J. NOWACZYK S-1143 WAUSAU, WIS. LAND SURVEYOR

Index No. 4-23