U.S. PUBLIC LAND SURVEY MONUMENT RECORD

Note: This form is intended and designed to fulfill all requirements of Wisconsin Administrative Code, Chapter A-E 5.02, U.S. Public Land Survey Monument Record (3) (a) (b) (c) (d) (e) (f) (g) (h) (i). An additional sheet may be added if necessary to conform with said requirements.

(a) Corner location: Township 31 North

Range 7 East

Town/~~City/Village~~ PINE RIVER

County LINCOLN

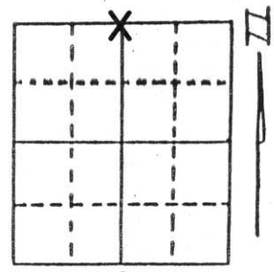

Section 21

(b) (f) (g) (h) Description of monument found at this corner and if it was accepted, state all evidence (material, testimonial, occupational, plats, records, other monuments) used as a basis for accepting. If not accepted or if nothing was found, state evidence used as basis for establishing location. If reestablished through lost corner proportionate methods, indicate all monuments, distances and directions used to establish.

Original corner - Wood Post set during Original Government Survey. Traversed from existing East 1/4 through NE to N1/4 to NW to existing West 1/4 to ascertain best location to excavate for corner. Discussed situation with Mr. Henry Wilharms, Sr. longtime local resident who was familar with other corners in area. He pointed out an old roadbed running to South from corner, the remains of which are still in evidence. Began excavating at spot he pointed out as it was consistent with position determined by our traverse. Excavated area 5' wide x 16 feet long to depth of 6 feet. Bottom of excavation was below original ground surface. Found no trace of corner monument, which presumably was a granite stone. Set standard Lincoln County Berntsen at point indicated by Mr. Wilharms as best evidence of corner location, point confirmed by traverse. Top of monument is about 5 inches below roadway surface.

(c) (d) (e) Plan view of corner with ties to at least 4 witness monuments. If in disagreement with previously established corner, show the distances between the two corners and also indicate the ties to the disputed corner.

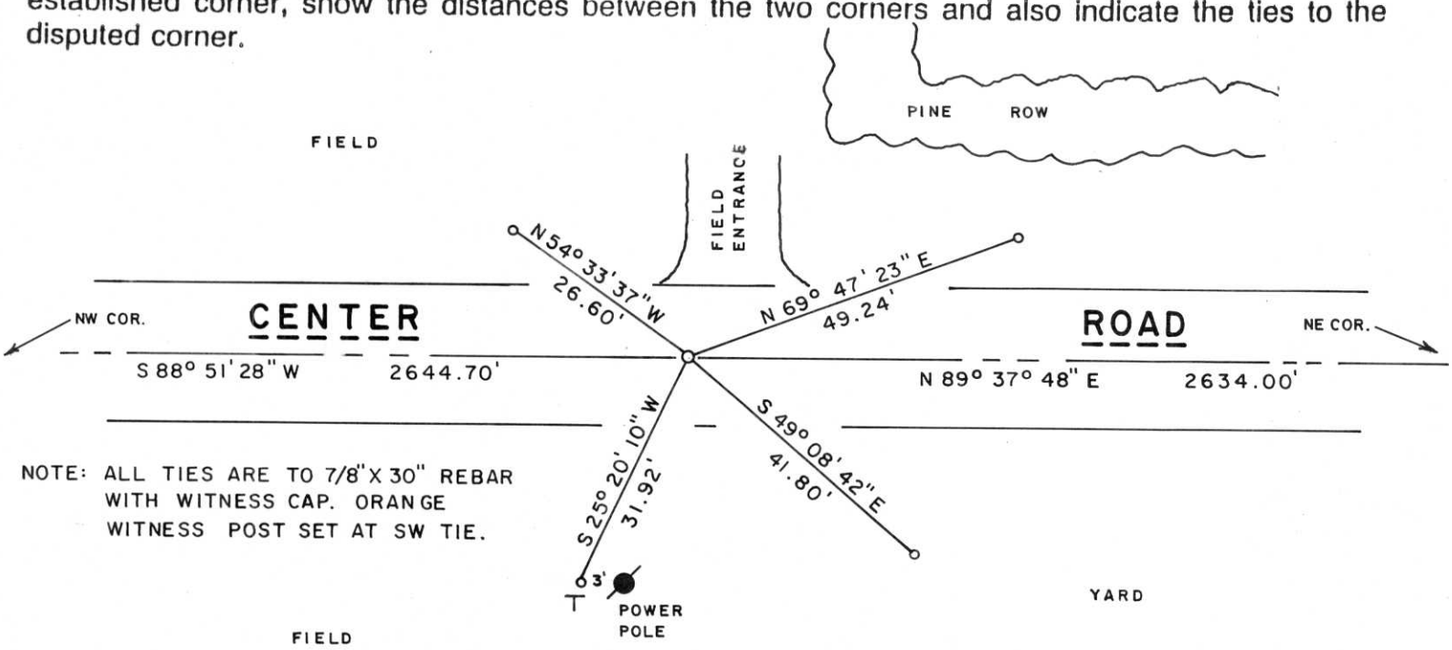

NOTE: ALL TIES ARE TO 7/8"X 30" REBAR WITH WITNESS CAP. ORANGE WITNESS POST SET AT SW TIE.

(i) I, LaVerne H. Mosher (type or print name) certify that the corner location on this record was determined by me or under my direction and control and that this U.S. Public Land Survey Monument Record is correct and complete to the best of my knowledge and belief.

LaVerne H. Mosher — 07/14/95

Signature — Date

WISCONSIN LaVERNE H. MOSHER S-1188 SCHOFIELD, WI LAND SURVEYOR

Index No. 11-11