LINCOLN COUNTY U.S. PUBLIC LAND SURVEY MONUMENT LOCATION RECORD

CORNER NUMBER 43187
TOWNSHIP 31 NORTH
RANGE 8 EAST
PINE RIVER
CITY, VILLAGE, TOWN

NO.

☒ LANDMARK ☐ BENCHMARK _____ FOUND ☒ SET ☐ RESET ☐ RE-TIED ☐

CORNER IDENTITY: SOUTH 1/4 CORNER

LINCOLN COUNTY COORDINATE: N: 126765.65
E: 441916.07

ELEVATION–(FEET): _____ DATUM: _____

WEATHER: SNOWING

DATE OF SURVEY: 12-15-05 TEMPERATURE: 30 °F

SURVEY PARTY: NATHAN WINCENTSEN, KEITH WALKOWSKI

SECTION

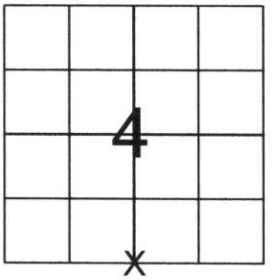

LOCATION (Indicated By X)

N

BASIS FOR MONUMENT LOCATION:

(DESCRIBE METHOD OF SURVEY AND CORNER AUTHENTICATION)

SEARCHED FOR SOUTH 1/4 CORNER, FOUND GRANITE STONE PROTRUDING 0.8 FEET ABOVE GRADE. ACCEPTED STONE AS SOUTH 1/4 CORNER AND PERPETUATED AS SHOWN BELOW.

WISCONSIN
KEITH J. WALKOWSKI
S-2717
MOSINEE, WI
LAND SURVEYOR

CERTIFIED CORRECT:
Keith J. Walkowski
KEITH J. WALKOWSKI
Registered Land Surveyor
DATE: Jan. 3RD, 2006

FIELD BOOK NO. PINE RIVER PAGE NO. 45

COMPANY RIVERSIDE LAND SURVEYING LLC

TIE SKETCH:

SHOW MINIMUM OF FOUR (4) HORIZONTAL TIE DISTANCES TO FIXED WITNESS MONUMENTS. DESCRIBE ALL MONUMENTS FOUND OR SET. CORRECT ALL DISTANCES SHOWN TO STANDARD TEMPERATURE OF 68° F.

■ -FOUND GRANITE STONE

○ -SET 3/4" REBAR WITH ALUMINUM CAPS

⊤ -VINYL SURVEY MARKER POST

NOTE

- ALL BEARINGS ARE FROM A HAND HELD MAGNETIC COMPASS
- THIS DRAWING IS NOT TO SCALE

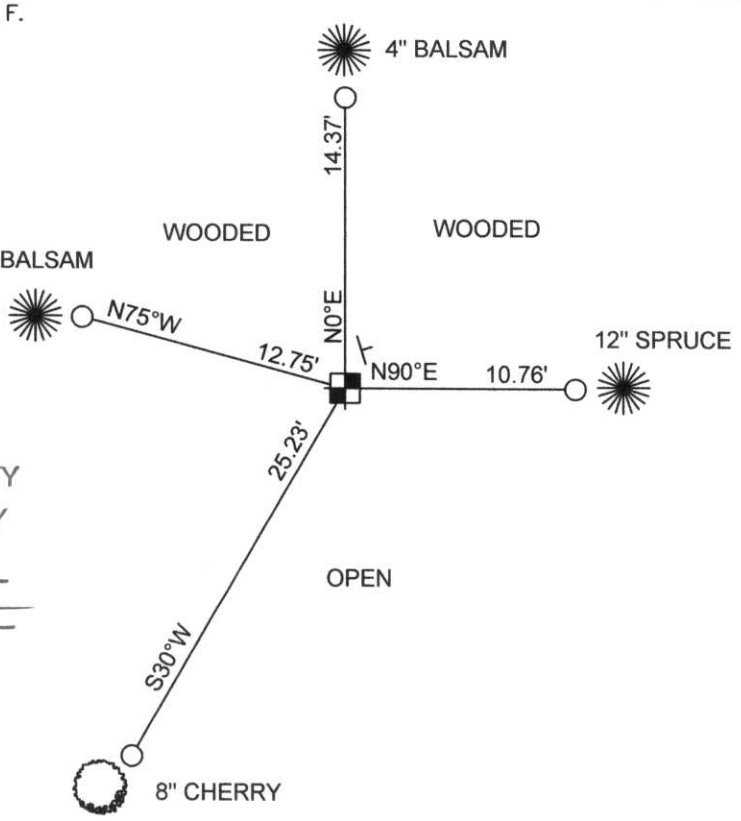

RECEIVED BY LINCOLN COUNTY SURVEYOR THIS 6TH DAY OF January 20 06
Tony Dahlke
COUNTY SURVEYOR

E-11