RECEIVED BY LINCOLN COUNTY SURVEYOR THIS 11TH DAY OF November 20 04

Tony Walk

COUNTY SURVEYOR

U.S. PUBLIC LAND SURVEY MONUMENT RECORD

Note: This form is intended and designed to fulfill all requirements of the Wisconsin Administrative Code, Chapter A-E 7.08 U.S. Public Land Monument Record (3)(a)(b)(c)(d)(e)(f)(g)(h)(i). An additional sheet may be added if necessary to confrom with said requirements.

(a) CORNER LOCATION:

east quarter corner of Section 36
Township 33 North
Range 5 East
Town of Harding
County of Lincoln

COORDINATES

North:
East:
Control Station:
Latitude:
Longitude:
Datum Method

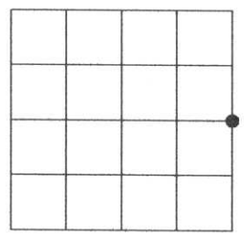

SECTION 36

(b) HISTORY OF ORIGINAL CORNER ESTABLISHMENT

Original Surveyor: J.M. Marsh
Date of Survey: Commenced July 1851
Completed August 1851

Original B.T.'S
Hemlock 24" dia., S10°E 33 links
Hemlock 8" dia, S18°W 55 links
Birch 8" dia., N50°W 28 links
Hemlock 18" dia., N40°E 31 links

(f)(g)(h) DESCRIPTION OF MONUMENT FOUND AT THIS CORNER AND IF IT WAS ACCEPTED, STATE ALL EVIDENCE (MATERIAL, TESTIMONIAL, OCCUPATIONS, PLATS, RECORDS, OTHER MONUMENTS) USED AS A BASISFOR ESTABLISHING LOCATION. IF NOT ACCEPTED OF IF NOTHING WAS FOUND, STATE EVIDENCE USED AS BASIS FOR ESTABLISHING LOCATION. IF REESTABLISHED THROUGH LOST CORNER PROPORTIONATE METHODS, INDICATE ALL MONUMENTS, DISTANCES AND DIRECTIONS USED TO ESTABLISH. INDICATE TYPE OF MONUMENT AND SIGN POST FOUND OR SET.

Original surveyor: J.M. Marsh, north between Sections 31 & 36 at 40 chains, set post for corner to ¼ section.

Francis Fox: date unknown, south between Sections 31 & 36, at 2634.4 set ¼ stone west 238.9'. Oak 7" dia. N49E 17.2' and Maple 6" dia. S14W 33.6', mounded with stone.

Michael L. Oestreich : July 2002, recovered 0.5' x 0.5' granite stone, with 36 & 31 chiseled on top. Set magnet next to stone, made new bearing trees and set reference monuments as shown in plan below.

(c)(d)(e) PLAN VIEW OF CORNER WITH TIES TO AT LEAST 4 WITNESS MONUMENTS. IF IN DISAGREEMENT WITH PREVIOUSLY ESTABLISHED CORNER, SHOW THE DISTANCE BETWEEN THE TWO CORNERS AND ALSO INDICATE THE TIES TO THE DISPUTED CORNER.

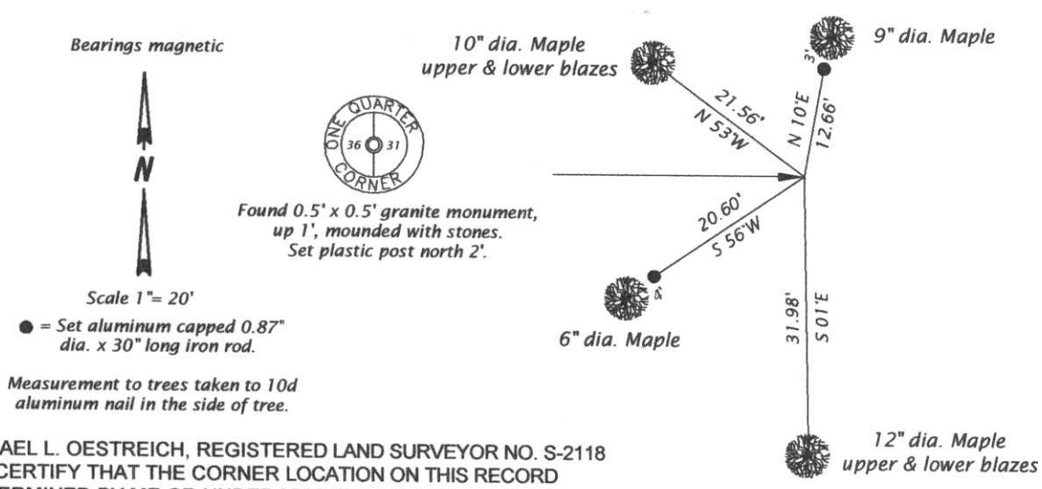

(i) I, MICHAEL L. OESTREICH, REGISTERED LAND SURVEYOR NO. S-2118 HEREBY CERTIFY THAT THE CORNER LOCATION ON THIS RECORD WAS DETERMINED BY ME OR UNDER MY DIRECTION AND CONTROL AND THAT THIS U.S. PUBLIC LAND SURVEY MONUMENT RECORD IS CORRECT AND COMPLETE TO THE BEST OF MY KNOWLEDGE AND BELIEF.

Michael L. Oestreich — SIGNATURE

WISCONSIN MICHAEL L. OESTREICH S-2118 MINOCQUA, WI LAND SURVEYOR

11/10/04 — DATE

INDEX NO. W-25

3/2/3