U.S. PUBLIC LAND SURVEY MONUMENT RECORD

Note: This form is intended and designed to fulfill all requirements of Wisconsin Administrative Code, Chapter A-E 5.02, U.S Public Land Survey Monument Record (3) (a) (b) (c) (d) (e) (f) (g) (h) (i). An additional sheet may be added if necessary to conform with said requirements.

(a) Corner location: Township 33 North

Range 6 East

Town/City/Village Rock Falls

County Lincoln

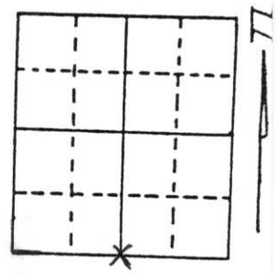

Section 4

(b) (f) (g) (h) Description of monument found at this corner and if it was accepted, state all evidence (material, testimonial, occupational, plats, records, other monuments) used as a basis for accepting. If not accepted or if nothing was found, state evidence used as basis for establishing location. If reestablished through lost corner proportionate methods, indicate all monuments, distances and directions used to establish.

The entire township was resurveyed in 1941 by Francis Fox. His notes call for a stone set at road the intersection. We dug for the stone but did not recover it. I used Fox's chainage from surrounding monuments which we found from his resurvey to set the corner location.

(c) (d) (e) Plan view of corner with ties to at least 4 witness monuments. If in disagreement with previously established corner, show the distances between the two corners and also indicate the ties to the disputed corner.

SOUTH 1/4 CORNER SECTION 4

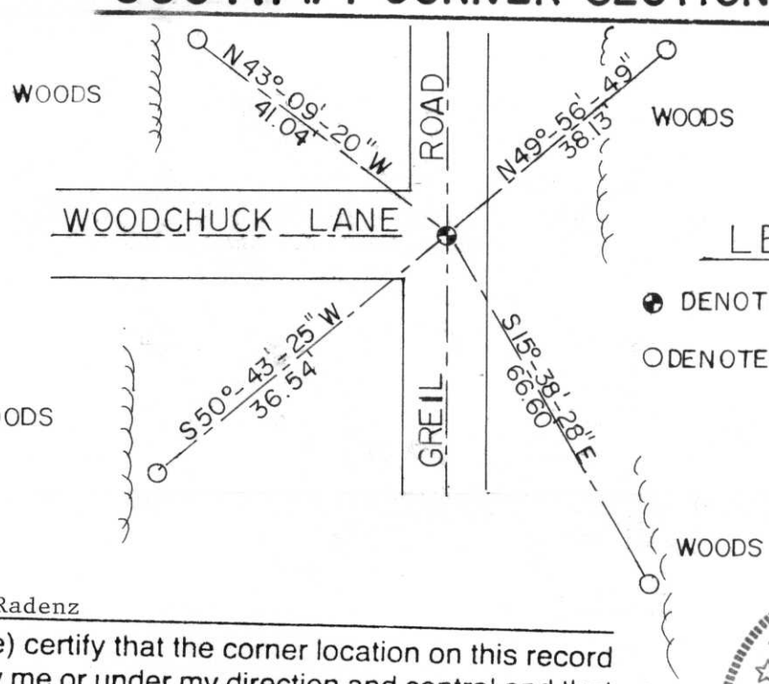

LEGEND

● DENOTES SET BERNSTEN MONUMENT

○ DENOTES SET 1" I.P

RECEIVED AT LINCOLN COUNTY COURTHOUSE THIS 21 DAY Feb 19 95 Pat Prielo TAX DESCRIPTION OFFICE

(i) I, Thomas A. Radenz (type or print name) certify that the corner location on this record was determined by me or under my direction and control and that this U.S. Public Land Survey Monument Record is correct and complete to the best of my knowledge and belief.

Thomas A. Radenz — Signature

2-9-95 — Date

WISCONSIN THOMAS A. RADENZ S-2095 WAUSAU WI LAND SURVEYOR

Index No. E-11