LINCOLN COUNTY U.S. PUBLIC LAND SURVEY MONUMENT LOCATION RECORD

CORNER NUMBER 143364
SECTION 14
TOWNSHIP 33 NORTH
RANGE 6 EAST
ROCK FALLS
CITY, VILLAGE, TOWN

NO.

☒ LANDMARK ☐ BENCHMARK _____

FOUND ☒
SET ☐
RESET ☐
RE-TIED ☒

CORNER IDENTITY: WEST 1/4 CORNER SECTION 14

LINCOLN COUNTY COORDINATE: N: 182427.27
E: 385933.50

ELEVATION-(FEET): _____ DATUM: _____

WEATHER: PARTLY CLOUDY

DATE OF SURVEY: 11-11-05 TEMPERATURE: 45 °F

SURVEY PARTY: NATHAN WINCENTSEN, KEITH WALKOWSKI

SECTION

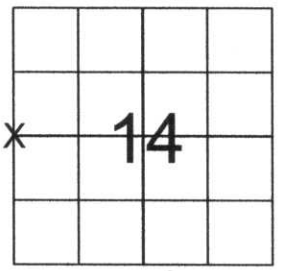

LOCATION
(Indicated By X)

N

BASIS FOR MONUMENT LOCATION:

(DESCRIBE METHOD OF SURVEY AND CORNER AUTHENTICATION)

FOUND SCRIBED GRAY GRANITE STONE IN MOUND OF ROCKS. ACCEPTED STONE AS CORNER AND PERPETUATED CORNER AS SHOWN BELOW.

WISCONSIN
KEITH J. WALKOWSKI
S-2717
MOSINEE, WI
LAND SURVEYOR

CERTIFIED CORRECT: Keith J. Walkowski
Registered Land Surveyor

DATE: Nov. 27TH, 2005

FIELD BOOK NO. 6 PAGE NO. 14

COMPANY RIVERSIDE LAND SURVEYING LLC

TIE SKETCH:

SHOW MINIMUM OF FOUR (4) HORIZONTAL TIE DISTANCES TO FIXED WITNESS MONUMENTS. DESCRIBE ALL MONUMENTS FOUND OR SET. CORRECT ALL DISTANCES SHOWN TO STANDARD TEMPERATURE OF 68° F.

-FOUND GRANITE STONE

○ -SET 3/4" REBAR WITH ALUMINUM CAPS

⊤ -VINYL SURVEY MARKER POST

NOTE

- ALL BEARINGS ARE FROM A HAND HELD MAGNETIC COMPASS
- THIS DRAWING IS NOT TO SCALE

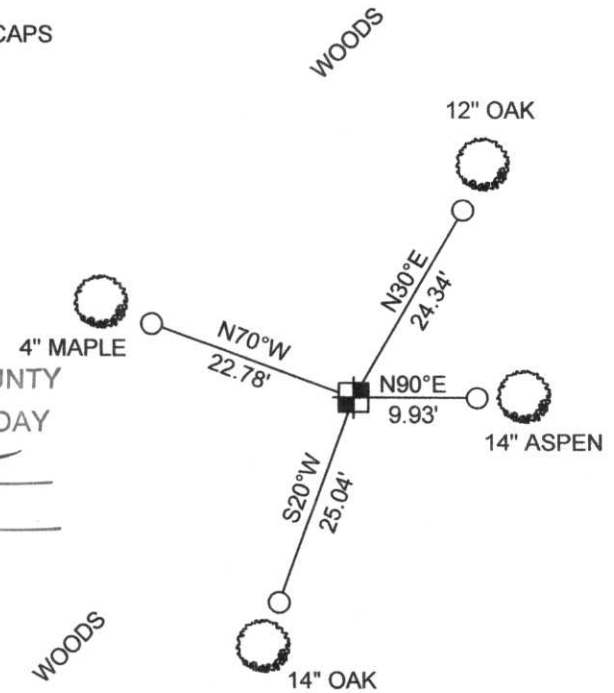

RECEIVED BY LINCOLN COUNTY SURVEYOR THIS 1ST DAY OF December 2005
Tony Walk
COUNTY SURVEYOR

K-17