LINCOLN COUNTY U.S. PUBLIC LAND TIE SHEET RECORD

SECTION 3
TOWNSHIP 33N
RANGE 4 E

CORNING
~~CITY, VILLAGE~~, TOWN

33343
NO.

☒ LANDMARK

CORNER INDENTITY: 6x6 GRANITE MONUMENT

LINCOLN COUNTY COORDINATE: N: 195734.722
E: 322809.204

DATE OF SURVEY: December 16, 2007
SURVEY PARTY: Eron

FOUND ☒
SET ☐
RE-SET ☐
RE-TIED ☐

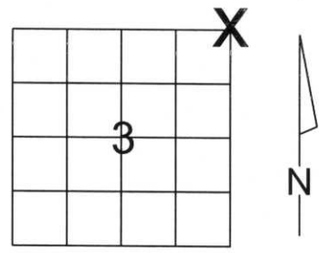

SECTION

Description of monument found at this corner and if was accepted, state all evidence (material, testimonial, occupational, plats, records, other monuments) used as a basis for accepting. If not accepted or if nothing was found, state evidence used as basis for establishing location. If reestablished through lost corner proportionate methods, indicate all monuments, distances and directions used to establish.

BASIS FOR MONUMENT LOCATION:

(DESCRIBE METHOD OF SURVEY AND CORNER AUTHENTICATION)
Found 6x6 Granite Monument, 1.0" Iron Pipe, and Wood Post at corner. Blue lines, property evidence, and comparison to the original notes supports the 6x6 Granite Monument, 1.0" Iron Pipe, and Wood Post as corner.

WISCONSIN
RONALD K. JACOBSON
S-2059
WESTON, WI
LAND SURVEYOR

CWE, Inc.
5707 SCHOFIELD AVE.
WESTON, WISCONSIN
54476

PHONE: (715) 359-9400
FAX: (715) 355-4199

general@cwengineers.com
www.cwengineers.com

CERTIFIED CORRECT:

Ronald Jacobson RLS 2059-008
Registered Land Surveyor

DATE: January 25, 2008

TIE SKETCH:

SHOW MINIMUM OF FOUR (4) HORIZONTAL TIE DISTANCES TO FIXED WITNESS MONUMENTS.
DESCRIBE ALL MONUMENTS FOUND OR SET. ALL DISTANCES SHOWN IN US SURVEY FEET.

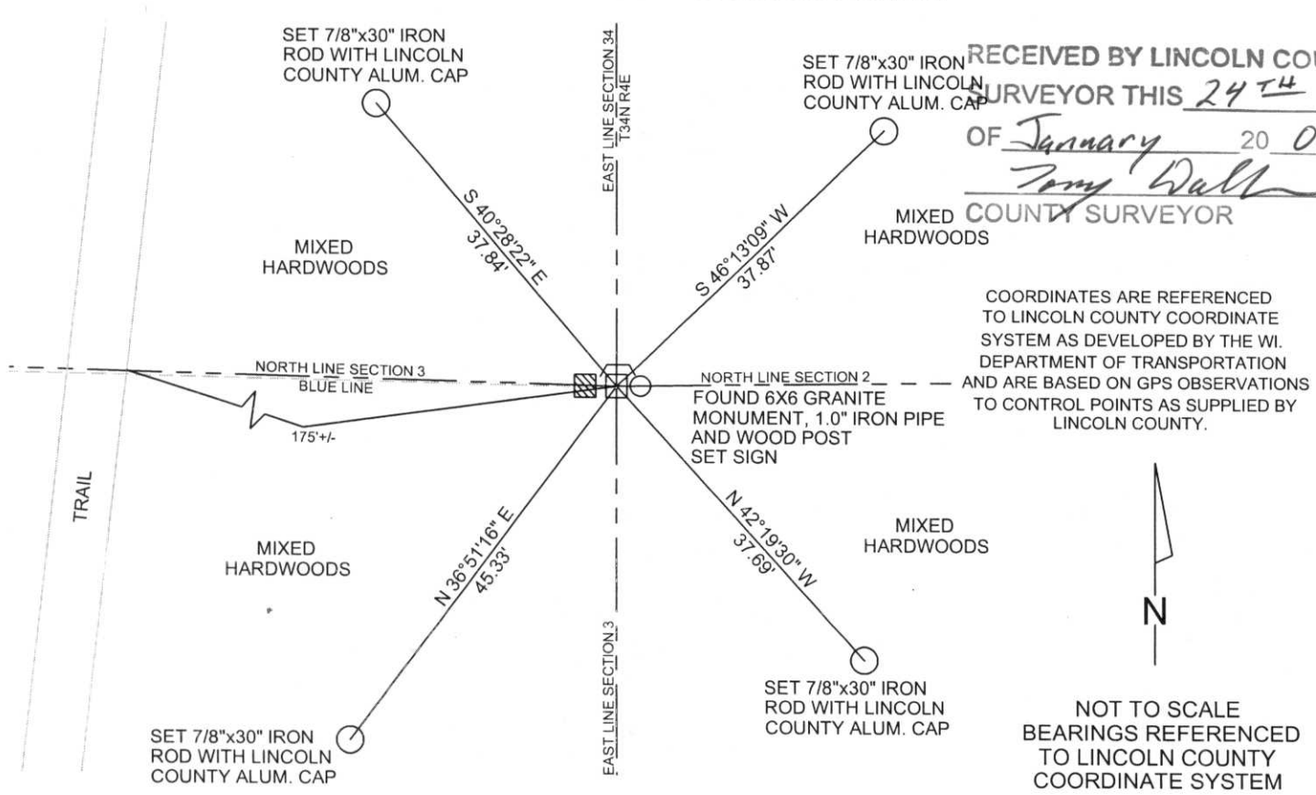

RECEIVED BY LINCOLN COUNTY SURVEYOR THIS 24TH DAY OF January 20 08
Tony Dall
COUNTY SURVEYOR

COORDINATES ARE REFERENCED TO LINCOLN COUNTY COORDINATE SYSTEM AS DEVELOPED BY THE WI. DEPARTMENT OF TRANSPORTATION AND ARE BASED ON GPS OBSERVATIONS TO CONTROL POINTS AS SUPPLIED BY LINCOLN COUNTY.

NOT TO SCALE
BEARINGS REFERENCED TO LINCOLN COUNTY COORDINATE SYSTEM

A-17

Picture 1 – Looking North From Corner

Picture 2 – Looking East From Corner

Picture 3 – Looking South From Corner

Picture 4 – Looking West From Corner at Blue Line

Picture 5 –Found 6x6 Granite Stone, Wood Post and 1 inch Iron Pipe at Corner

Picture 6 –Found 6x6 Granite Stone, Wood Post and 1 inch Iron Pipe at Corner