LINCOLN COUNTY U.S. PUBLIC LAND SURVEY MONUMENT LOCATION RECORD

CORNER NUMBER 33455
SECTION 3
TOWNSHIP 34
RANGE 5
TOMAHAWK
CITY, VILLAGE, TOWN

NO.

☒ LANDMARK ☐ BENCHMARK _____

FOUND ☐
SET ☒
RESET ☐
RE-TIED ☐

CORNER IDENTITY: EAST 1/4 CORNER

LINCOLN COUNTY COORDINATE: N: 225001.38
E: 354354.80

ELEVATION-(FEET): _____ DATUM: _____

WEATHER: RAIN

DATE OF SURVEY: 5-20-06 TEMPERATURE: 50 °F

SURVEY PARTY: KYLE FISCHER, KEITH WALKOWSKI

SECTION

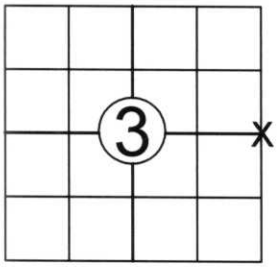

LOCATION
(Indicated By X)

N

BASIS FOR MONUMENT LOCATION:

(DESCRIBE METHOD OF SURVEY AND CORNER AUTHENTICATION)

SEARCHED FOR EAST 1/4 CORNER AND FOUND A 1" IRON PIPE AS SHOWN ON A PLAT OF SURVEY DATED 1-10-15 BY FAVORITE SURVEYING. THE IRON PIPE MATCHES A ROCK FENCE AND DOWNED FENCE LINE TO THE WEST. HELD IRON AS BEST AVAILABLE EVIDENCE AND REPLACED IT WITH A LINCOLN COUNTY BERNSTEN MONUMENT. PERPETUATED CORNER AS SHOWN BELOW.

WISCONSIN
KEITH J. WALKOWSKI
S-2717
MOSINEE, WI
LAND SURVEYOR

FIELD BOOK NO. 8 PAGE NO. 16

COMPANY RIVERSIDE LAND SURVEYING

CERTIFIED CORRECT:
Keith J. Walkowski
KEITH WALKOWSKI
Registered Land Surveyor
DATE: 6-12-06

TIE SKETCH:

SHOW MINIMUM OF FOUR (4) HORIZONTAL TIE DISTANCES TO FIXED WITNESS MONUMENTS. DESCRIBE ALL MONUMENTS FOUND OR SET. CORRECT ALL DISTANCES SHOWN TO STANDARD TEMPERATURE OF 68° F.

-SET BERNSTEN

-SET 3/4" REBAR WITH ALUMINUM CAPS

-VINYL SURVEY MARKER POST

FOUND 1 1/2" IP ± 2' ABOVE GROUND

NOTE

- ALL BEARINGS ARE FROM A HAND HELD MAGNETIC COMPASS
- COORDINATES ARE BASED ON THE LINCOLN COUNTY COORDINATE SYSTEM AND REFERENCED TO GPS BASE STATION BRADLEY SOUTH.
- THIS DRAWING IS NOT TO SCALE

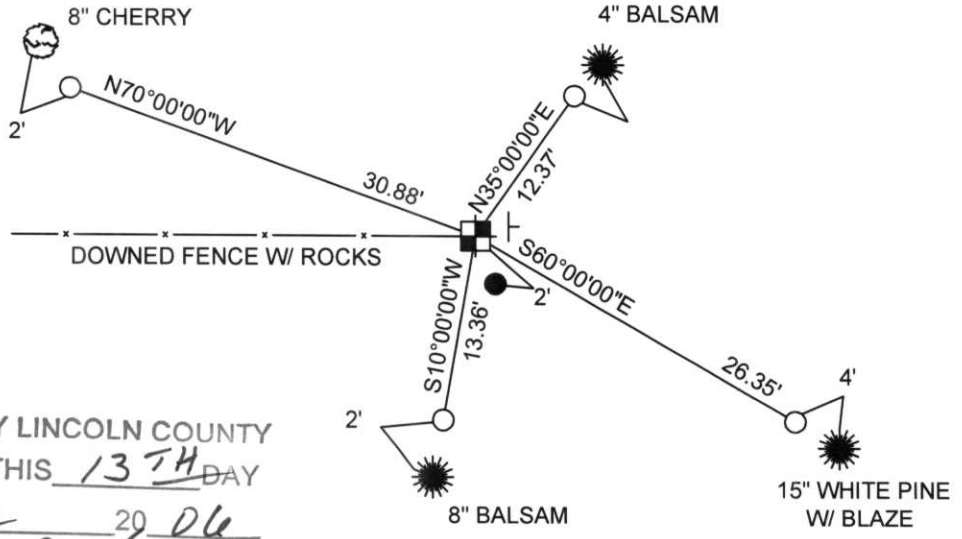

RECEIVED BY LINCOLN COUNTY SURVEYOR THIS 13TH DAY OF June 20 06
Tony Wall
COUNTY SURVEYOR

7-17