FORM NO. 765-A

HCMiller
Print Evolutionaries

Stock No. 26273

# U.S. PUBLIC LAND SURVEY MONUMENT RECORD

Note: This form is intended and designed to fulfill all requirements of Wisconsin Administrative Code, Chapter A–E 5.02, U.S. Public Land Survey Monument Record (3)(a)(b)(c)(d)(e)(f)(g)(h)(i). An additional sheet may be added if necessary to conform with said requirements.

(a) Corner location: Township 34 North

Range 6 East

Town/City/Village BRADLEY

County LINCOLN

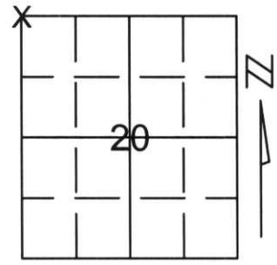


Section 20

(b)(f)(g)(h) Description of monument found at this corner and if it was accepted, state all evidence (material, testimonial, occupational, plats, records, other monuments)used as a basis for accepting. If not accepted or if nothing was found, state evidence used as basis for establishing location. If reestablished through lost corner proportionate methods, indicate all monuments, distances and directions used to establish.

WE FOUND A 2" IRON PIPE. THE LANDOWNER OF ADJOINING LANDS SAID HIS GRANDFATHER HAD THE LAND SURVEYED WHEN HE OWNED IT AND THE 2" IRON WAS SET THEN. THE IRON FITS LINE WITH THE 40 CORNER TO THE SOUTH AND THE WITNESS CORNER FOR THE WEST 1/4 . DISTANCE TO THE WEST 1/4 FITS ORIGINAL CHAINAGE WITH IN 5 FEET. EXCEPTED CORNER LOCATION. TIED OUT MONUMENT TO PERPETUATE CORNER LOCATION.

RECEIVED AT LINCOLN COUNTY COURTHOUSE THIS 9TH DAY OF January 20 02

Tony Dallman

LAND INFORMATION OFFICE

(c)(d)(e) Plan view of corner with ties to at least 4 witness monuments. If in disagreement with previously established corner, show the distances between the two corners and also indicate the ties to the

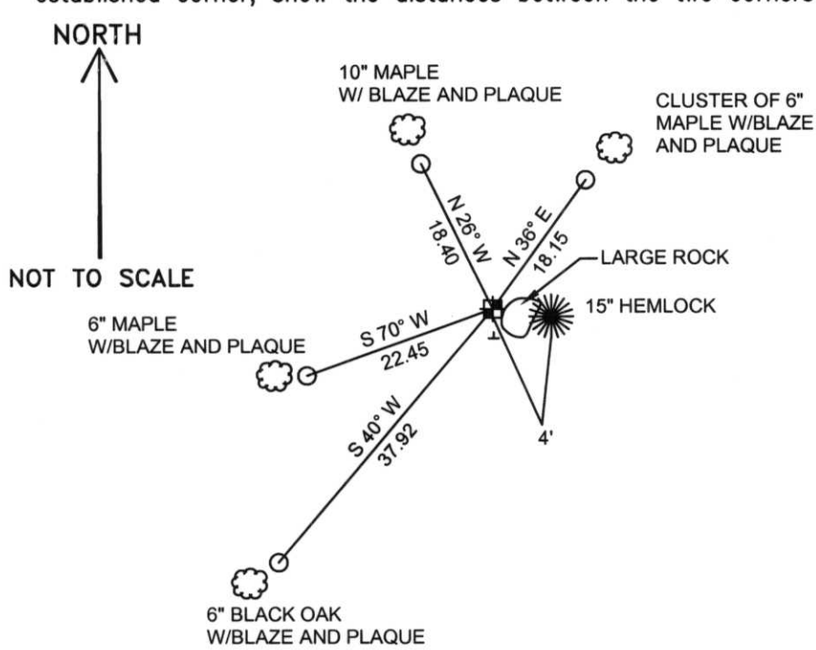


COORDINATES ARE REFERENCED TO THE LINCOLN COUNTY COORDINATE SYSTEM AS DEVELOPED BY THE WISCONSIN DEPARTMENT OF TRANSPORTATION AND WERE DETERMINED BY GPS OBSERVATIONS ON CONTROL POINTS AS SUPPLIED BY LINCOLN COUNTY.

BEARINGS ARE REFERENCED TO MAGNETIC NORTH.

○ - SET 3/4" x 30" REBAR W/ ALUM CAP 1' FROM BEARING TREE

✚ - NORTHWEST CORNER FOUND 2" IRON PIPE

⊢ - SET VINYL POST

(i) I, Thomas A. Radenz, RLS certify that the corner location on this record was determined by me or under my direction and control and that this U.S. Public Land Survey Monument Record is correct and complete to the best of my knowledge and belief.

WISCONSIN THOMAS A. RADENZ S-2095 WAUSAU WI LAND SURVEYOR

Thomas A. Radenz 1/8/2002

Signature Date

Index No. .....

5-M