U.S. PUBLIC LAND SURVEY MONUMENT RECORD

Note: This form is intended and designed to fulfill all requirements of Wisconsin Administrative Code, Chapter A-E 5.02, U.S. Public Land Survey Monument Record (3) (a) (b) (c) (d) (e) (f) (g) (h) (i). An additional sheet may be added if necessary to conform with said requirements.

(a) Corner location: Township 34 North

Range 6 East

Town Bradley

County Lincoln

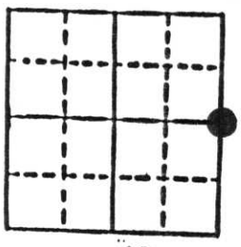

Section 18

b) (f) (g) (h) Description of monument found at this corner and if it was accepted, state all evidence (material, testimonial, occupational, plats, records, other monuments) used as a basis for accepting. If not accepted or if nothing was found, state evidence used as basis for establishing location. If reestablished through lost corner proportionate methods, indicate all monuments, distances and directions used to establish. Original Gov't. Survey: Jan. 1855 by Jackson Prentice, set wood post for corner with bearings, birch 10 N 33° E 14 links & spruce 6 S 30° W 18 links. I found no monument for the corner. I found a 1" iron pipe 33' south of the intersection of the centre-line of County Trunk Highway "O" from the east & west with the southerly extension of the centre-line of Belliveau Road and set a Berntsen monument at said intersection for the corner.

c) (d) (e) Plan view of corner with ties to at least 4 witness monuments. If in disagreement with previously established corner, show the distances between the two corners and also indicate the ties to the disputed corner.

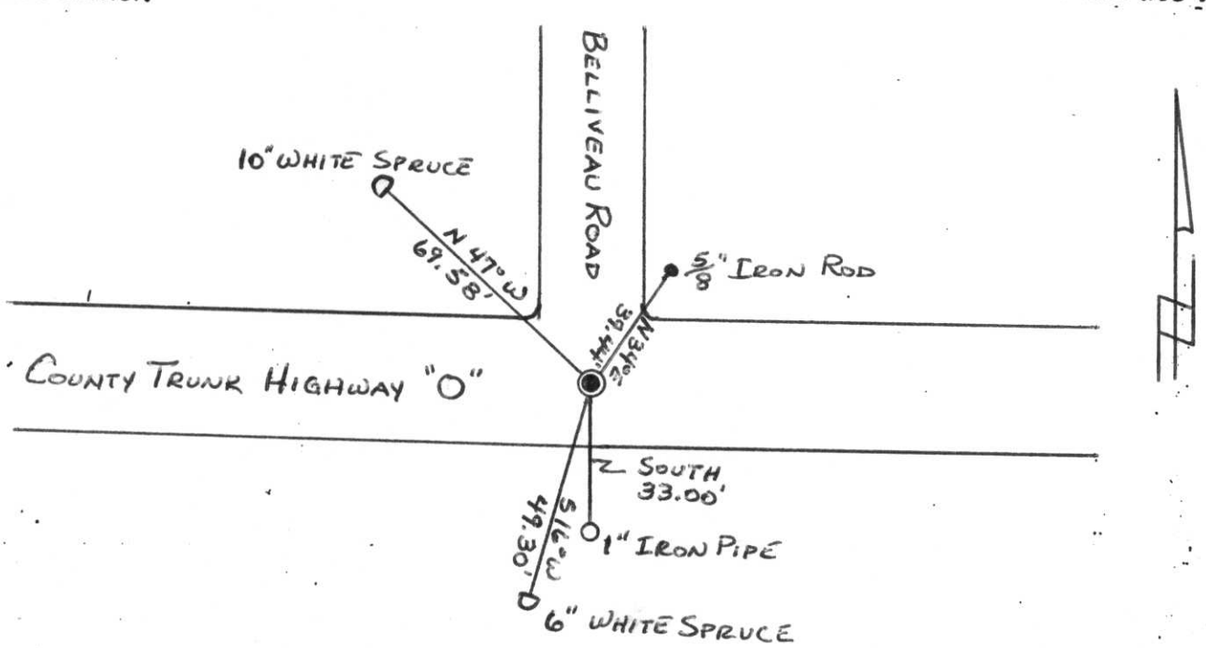

(i) I, Lester J. Schmit (type or print name) **certify that the corner location on this record was determined by me or under my direction and control and that this U.S. Public Land Survey Monument Record is correct and complete to the best of my knowledge and belief.**

Lester J. Schmit — Signature

11 Aug 86 — Date

WISCONSIN — AFFIX SEAL HERE — LESTER J. SCHMIT S-1192 EDMAHAWK, WIS. — LAND SURVEYOR

Index No. K-5