U.S. PUBLIC LAND SURVEY MONUMENT RECORD

Note: This form is intended and designed to fulfill all requirements of Wisconsin Administrative Code, Chapter A-E 5.02, U.S. Public Land Survey Monument Record (3) (a) (b) (c) (d) (e) (f) (g) (h) (i). An additional sheet may be added if necessary to conform with said requirements.

(a) Corner location: Township 35 North

Range 5 East

Town Wilson

County Lincoln

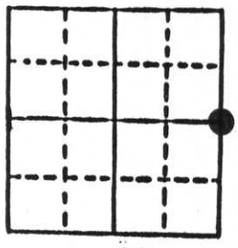

Section 22

b) (f) (g) (h) Description of monument found at this corner and if it was accepted, state all evidence (material, testimonial, occupational, plats, records, other monuments) used as a basis for accepting. If not accepted or if nothing was found, state evidence used as basis for establishing location. If reestablished through lost corner proportionate methods, indicate all monuments, distances and directions used to establish. Original Gov't. Survey: Oct. 1862 by Joseph H. Jenkins, set wood post for corner with bearings, white pine 8 S 34° W 2 links & birch 10 N 42° E 2 links. I found a 1½" iron pipe set by William H. Stuth on survey in Nov. 1984. Mr. Stuth (S 1418) set the corner equidistant and on a straight line between the Southeast & Northeast corners of Section 22.

c) (d) (e) Plan view of corner with ties to at least 4 witness monuments. If in disagreement with previously established corner, show the distances between the two corners and also indicate the ties to the disputed corner.

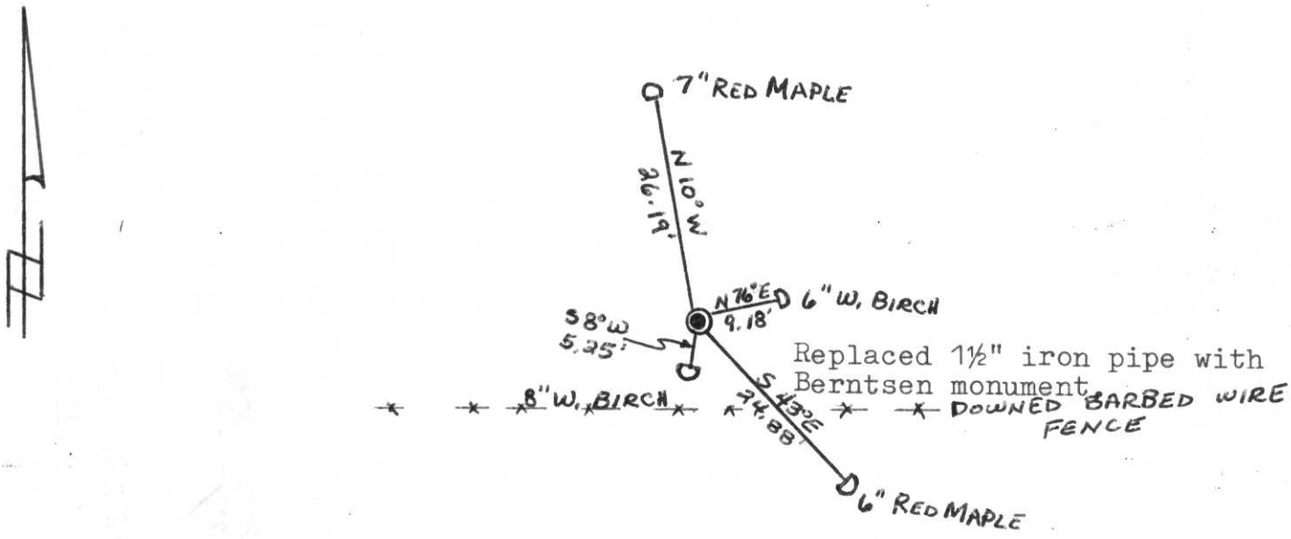

(i) I, Lester J. Schmit

(type or print name) certify that the corner location on this record was determined by me or under my direction and control and that this U.S. Public Land Survey Monument Record is correct and complete to the best of my knowledge and belief.

Lester J. Schmit — 9 Sep 85

Signature — **Date**

WISCONSIN
LESTER J. SCHMIT
S-1418
TOMAHAWK, WIS.
LAND SURVEYOR

Index No. 0-17