LINCOLN COUNTY U.S. PUBLIC LAND SURVEY MONUMENT LOCATION RECORD

CORNER NUMBER 33452
SECTION 3
TOWNSHIP 34
RANGE 5
TOMAHAWK
CITY, VILLAGE, TOWN

NO.

☒ LANDMARK ☐ BENCHMARK _____ FOUND ☐ SET ☒ RESET ☐ RE-TIED ☐

CORNER IDENTITY: NORTH 1/4 CORNER

LINCOLN COUNTY COORDINATE: N: 227144.88
E: 351748.44

ELEVATION–(FEET): _____ DATUM: _____

WEATHER: RAIN

DATE OF SURVEY: 5-20-06 TEMPERATURE: 50 °F

SURVEY PARTY: KYLE FISCHER, KEITH WALKOWSKI

SECTION

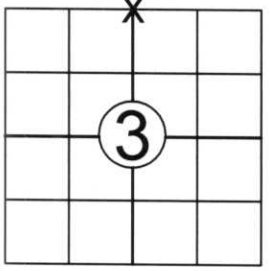

LOCATION (Indicated By X)

N

BASIS FOR MONUMENT LOCATION:

(DESCRIBE METHOD OF SURVEY AND CORNER AUTHENTICATION)

SEARCHED FOR NORTH 1/4 CORNER AND FOUND A 4X4 SCRIBED POST WITH 1" IRON PIPE ADJACENT TO IT. THIS BEING CONSISTENT WITH OTHER CORNERS IN THE SECTION. THE POST AND PIPE WERE REFERENCED BY NUMEROUS OLD BLAZED TREES. THE DISTANCE TO THE NORTHWEST AND NORTHEAST CORNERS FIT WELL WITH ORIGINAL CHAINAGE. WE HELD POSTS POSITION AS BEST AVAILABLE EVIDENCE AND SET A BERNSTEN MONUMENT IN ITS PLACE. PERPETUATED CORNER AS SHOWN BELOW.

WISCONSIN
KEITH J. WALKOWSKI
S-2717
MOSINEE, WI
LAND SURVEYOR

FIELD BOOK NO. 8 PAGE NO. 15

COMPANY RIVERSIDE LAND SURVEYING

CERTIFIED CORRECT: Keith J. Walkowski

KEITH WALKOWSKI
Registered Land Surveyor

DATE: 6-12-06

TIE SKETCH:

SHOW MINIMUM OF FOUR (4) HORIZONTAL TIE DISTANCES TO FIXED WITNESS MONUMENTS. DESCRIBE ALL MONUMENTS FOUND OR SET. CORRECT ALL DISTANCES SHOWN TO STANDARD TEMPERATURE OF 68° F.

- -SET BERNSTEN
- -SET 3/4" REBAR WITH ALUMINUM CAPS
- -VINYL SURVEY MARKER POST
- -RE-SET 1" IRON PIPE AS REFERENCE

NOTE

- ALL BEARINGS ARE FROM A HAND HELD MAGNETIC COMPASS
- COORDINATES ARE BASED ON THE LINCOLN COUNTY COORDINATE SYSTEM AND REFERENCED TO GPS BASE STATION BRADLEY SOUTH.
- THIS DRAWING IS NOT TO SCALE

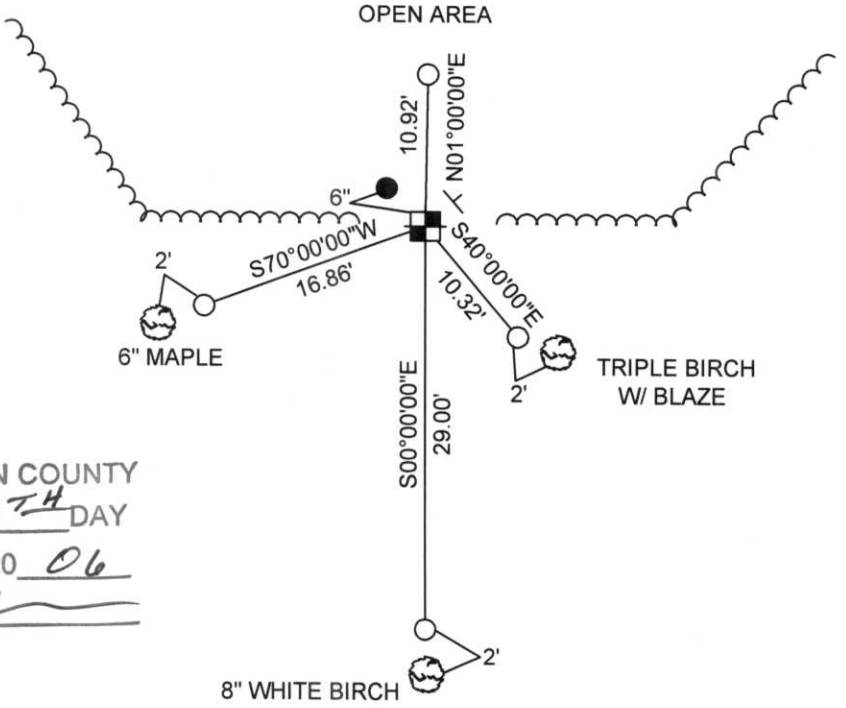

RECEIVED BY LINCOLN COUNTY SURVEYOR THIS 13TH DAY OF June 20 06

Tony Dahl
COUNTY SURVEYOR

A-13