U.S. PUBLIC LAND SURVEY MONUMENT RECORD

NOTE: This form is intended and designed to fulfill all requirements of Wisconsin Administrative Code, Chapter A-E 7.08 U.S. Public Land Survey Monument Record (3)(a)(b)(c)(d)(e)(f)(g)(h)(i). An additional sheet may be added if necessary to conform with said requirements.

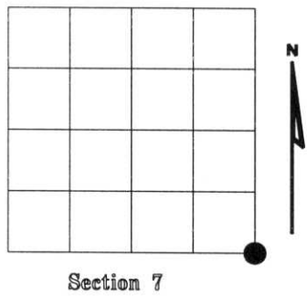

Section 7

(a) Corner location: Township 35 North

Range 07 East

Town of KING

LINCOLN County, Wisconsin

(b)(f)(g)(h) Description of monument found at this corner and if it was accepted, state all evidence (material, testimonial, occupational, plats, records, other monuments) used as a basis for accepting. If not accepted or if nothing was found, state evidence used as basis for establishing location. If reestablished through lost corner proportionate methods, indicate all monuments, distances and directions used to establish. Indicate type of monument found or set and sign post.

1861 - Original corner set by Alfred Millard

1960 - 1968 - 1969- Bill Stuth's notes shows corner by others found and accepted as corner
BT: 24" Oak N01°E 47.0'
22" Oak S08°E 14.0'

2003 - I found 1" dia. iron pipe with 90° elbow and sq. post accepted as corner.
23" Oak S08°E 14.0'
Replaced with Lincoln County Bernsten Monument stamped to identify corner.

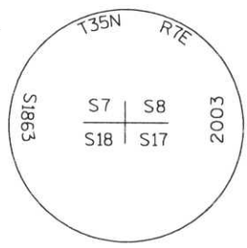

Witnessed as shown below.

(c)(d)(e) Plan view of corner with ties to at least 4 witness monuments. If in disagreement with previously established corner, show the distances between the two corners and also indicate the ties to the disputed corner.

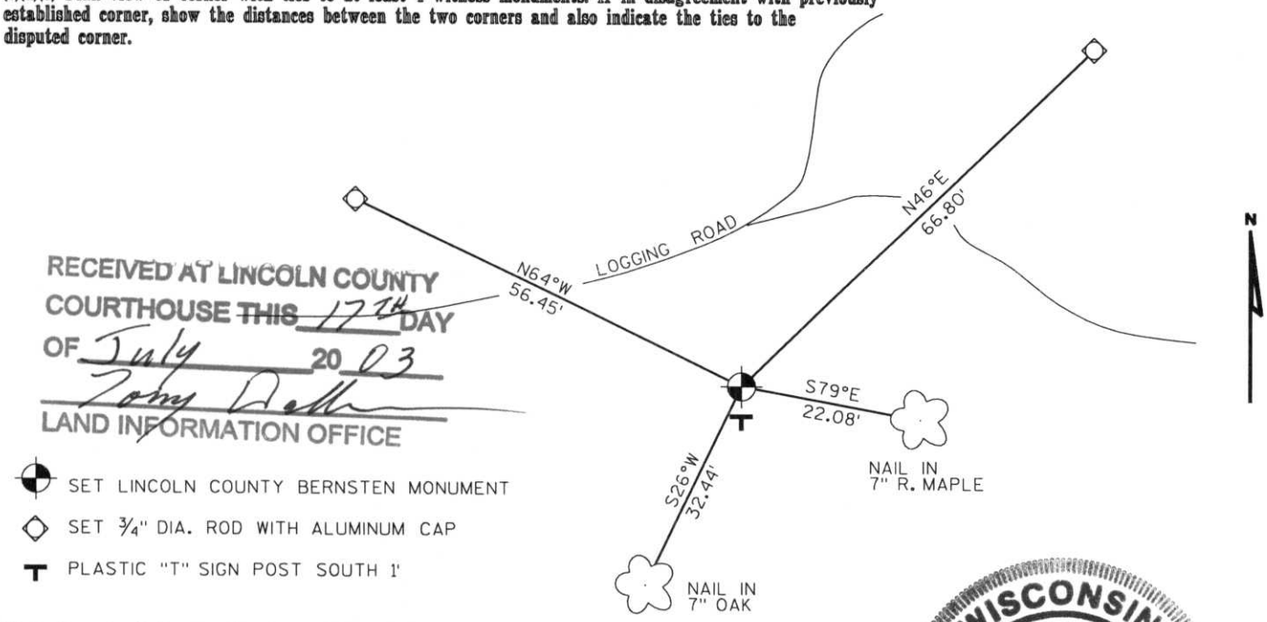

RECEIVED AT LINCOLN COUNTY COURTHOUSE THIS 17TH DAY OF July 2003
Tony Dell
LAND INFORMATION OFFICE

(i) I, Dennis Roberts, Registered Land Surveyor #S-1863, hereby certify that the corner location on this record was determined by me or under my direction and control and that this U.S. Public Land Survey Monument Record is correct and complete to the best of my knowledge and belief.

WISCONSIN
DENNIS B. ROBERTS
S-1863
RHINELANDER, WI 54501
LAND SURVEYOR

Dennis B. Roberts 6-20-03

Signature **Date**

Index No. T-5