U.S. PUBLIC LAND SURVEY MONUMENT RECORD

Note: This form is intended and designed to fulfill all requirements of Wisconsin Administrative Code, Chapter A-E 5.02, U.S. Public Land Survey Monument Record (3) (a) (b) (c) (d) (e) (f) (g) (h) (i). An additional sheet may be added if necessary to conform with said requirements.

(a) Corner location: Township 34 North

Range 7 East/West

Town/City/Village Skanawan

County Lincoln

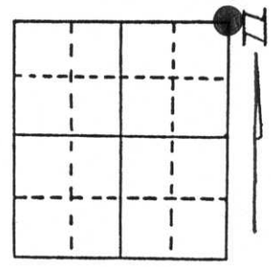

Section 3

(b) (f) (g) (h) Description of monument found at this corner and if it was accepted, state all evidence (material, testimonial, occupational, plats, records, other monuments) used as a basis for accepting. If not accepted or if nothing was found, state evidence used as basis for establishing location. If reestablished through lost corner proportionate methods, indicate all monuments, distances and directions used to establish. Origianl Gov't. Survey: Aug. 1851 by James M. Marsh, set wood post for corner with bearings, tamarack 8 S 56°E 24 links, tamarack 8 S 10° W 19 links, birch 7 N 66° W 21 links & birch 8 N 55° E 26 links. I found a 3/4" iron pipe for the corner. I replaced the 3/4" iron pipe with a Berntsen monument and referenced as shown below.

RECEIVED OCT 9 1991

(c) (d) (e) Plan view of corner with ties to at least 4 witness monuments. If in disagreement with previously established corner, show the distances between the two corners and also indicate the ties to the disputed corner.

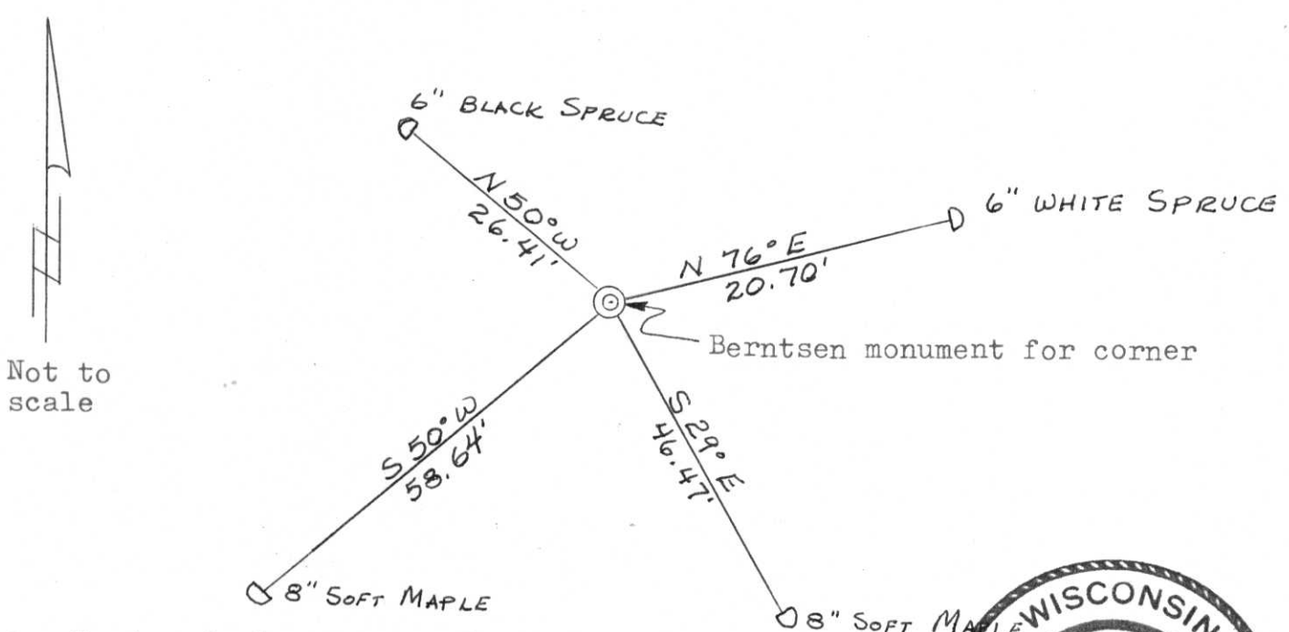

(i) I, Lester J. Schmit R.L.S. S-1192 (type or print name) certify that the corner location on this record was determined by me or under my direction and control and that this U.S. Public Land Survey Monument Record is correct and complete to the best of my knowledge and belief.

Lester J. Schmit 28 Sep 91

Signature Date

WISCONSIN LESTER J. SCHMIT S-1192 TOMAHAWK, WIS. LAND SURVEYOR

Index No. A-17