U.S. PUBLIC LAND SURVEY MONUMENT RECORD

Note: This form is intended and designed to fulfill all requirements of Wisconsin Administrative Code, Chapter A-E 5.02, U.S. Public Land Survey Monument Record (3) (a) (b) (c) (d) (e) (f) (g) (h) (i). An additional sheet may be added if necessary to conform with said requirements.

(a) Corner location: Township 35 North

Range 8 East

Town Harrison

County Lincoln

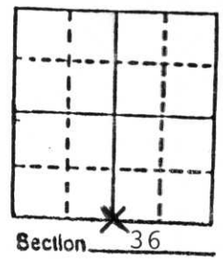

b) (f) (g) (h) Description of monument found at this corner and if it was accepted, state all evidence (material, testimonial, occupational, plats, records, other monuments) used as a basis for accepting. If not accepted or if nothing was found, state evidence used as basis for establishing location. If reestablished through lost corner proportionate methods, indicate all monuments, distances and directions used to establish.

August 1859 - Ran west between sections 1 and 36, T34-35N, R8E and at 80.00 chains set wood post for section corner:
10" Tamarack, N63°E, 22 links (14.52')
8" Tamarack, S60°E, 14 links (9.24')
8" White Pine, S52°W, 11 links (7.26')
10" Tamarack, N37°W, 20 links (13.20')

1937, Francis X. Fuchs found old stake and BT. He set a 6" x 6" x 30" granite in mound of stone and made new BTs:
7" White Pine, N6°W, 53.9 links (35.57')
14" Pine stump, S33°E, 65.9 links (43.50')
12" Old BT, S18°W, 24.7 links (16.3')

February 2, 1988 Milo E. Stefan found granite tipped out. With 18" White Pine - dead - stump blaze overgrown, N6°W, 35.8'. Large pine stump - scribe visible S18°W, 16.3'.

February 25, 1988 I reset the granite, 18" deep, in small mound of stone and made new BTs.

c) (d) (e) Plan view of corner with ties to at least 4 witness monuments. If in disagreement with previously established corner, show the distances between the two corners and also indicate the ties to the disputed corner.

1. 6" x 6" x 30" pink granite, 18" deep in mound of stone. Top of granite with 36
2. 6" Black Spruce, N84°E, 12.55'
3. 5" Hemlock, N86°W, 42.72'
4. 7" Black Spruce, N47°W, 15.34'
5. 14" White Pine, N15°W, 53.35'

All BTs scribed "1/4S BT"
Distances measured to nail in side of BTs.

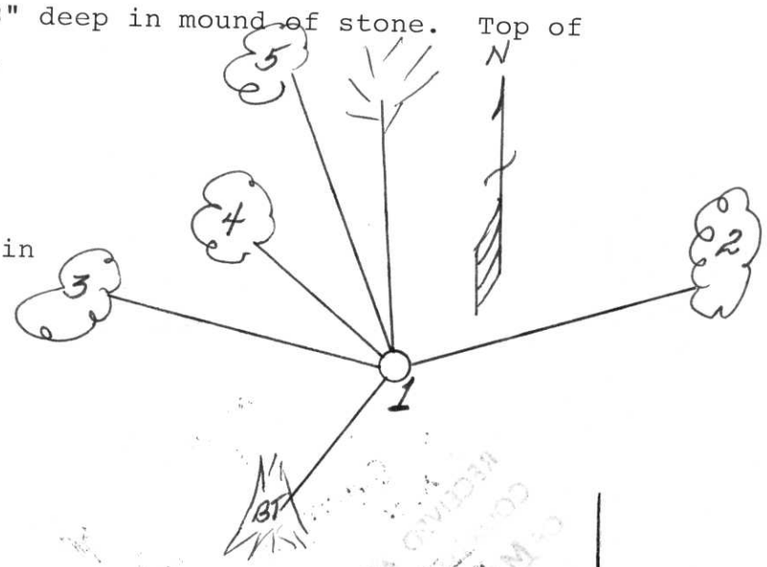

(i) I, Milo E. Stefan (type or print name) certify that the corner location on this record was determined by me or under my direction and control and that this U.S. Public Land Survey Monument Record is correct and complete to the best of my knowledge and belief.

Milo E Stefan — Signature

2/26/88 — Date

WISCONSIN MILO E. STEFAN S-1558 RHINELANDER, WIS. LAND SURVEYOR

Index No. 6-23